


Application No. G 11538
Permit No. G10628

RECEIVED
JUN 11 1986
WATER RESOURCES DEPT
SALEM, OREGON

T75 R2W SEC 21

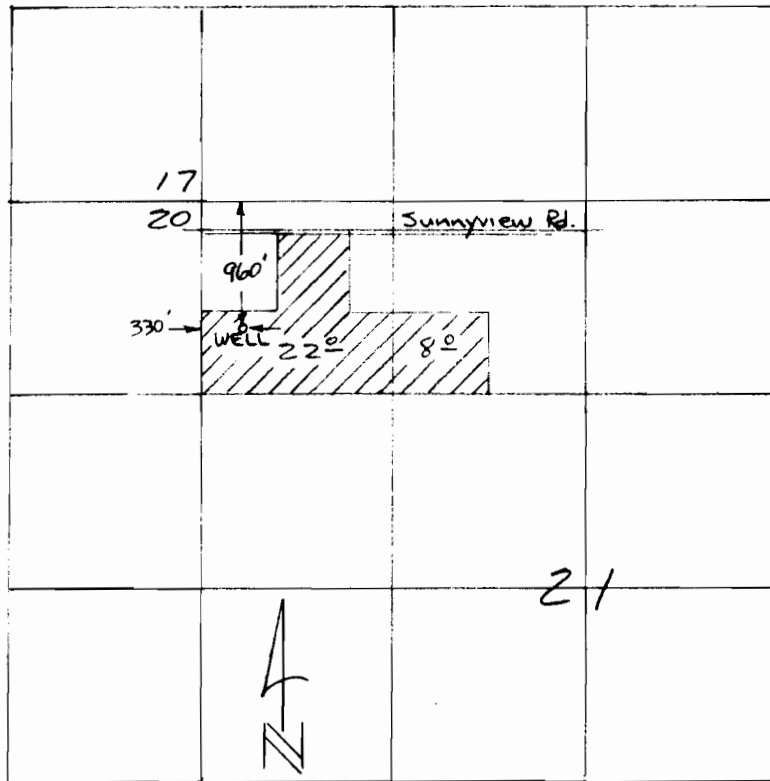

Scale 4" = 1 mile