

RECEIVED

JUN 18 1986

Application No. 8-11478 APR 21 1986

Permit No. G10634

RECEIVED

APR 21 1986


WATER RESOURCES DEPT
SALEM, OREGON

WATER RESOURCES DEPT
SALEM, OREGON

RECEIVED

JAN 17 1986

WATER RESOURCES DEPT
SALEM, OREGON

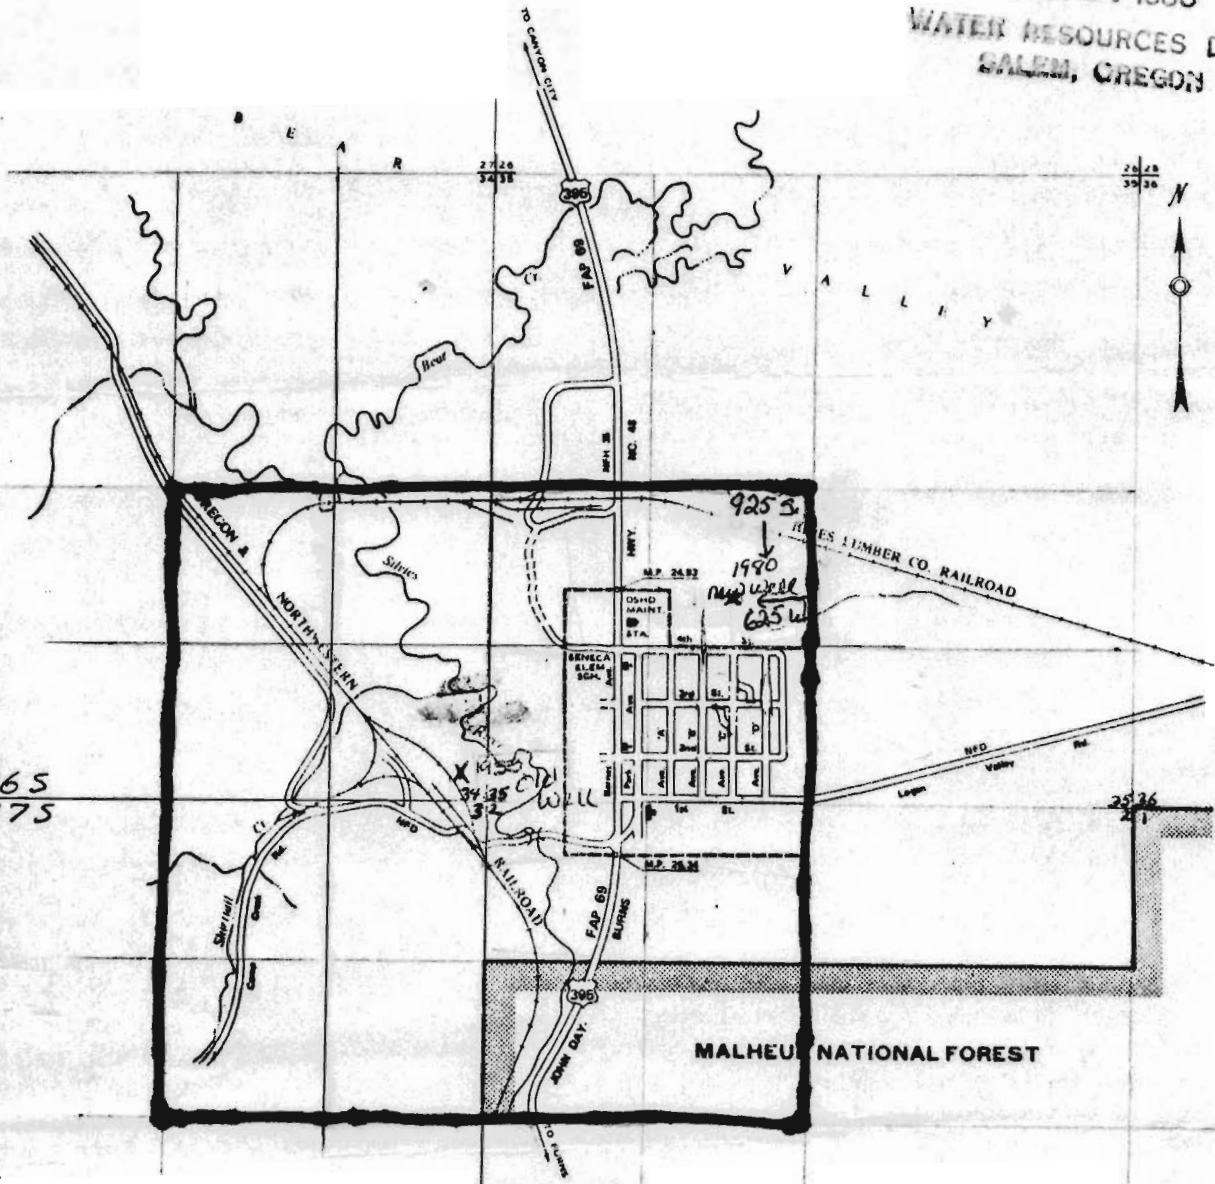

T 16 S R 31 E
T 17 S R 31 E

LEGEND

- INTERSTATE NUMBERED ROUTE
- U.S. NUMBERED ROUTE
- STATE NUMBERED ROUTE
- TERMINATION OF FA SYSTEM
- DIVIDED HIGHWAY
- STREET OPEN FOR TRAVEL
- POST OFFICE
- SCHOOL
- CITY CENTER
- CITY LIMITS
- PUBLIC AREA
- PUBLIC BUILDING
- COURT HOUSE
- CITY HALL
- ARMORY
- LIBRARY


SENECA

GRANT COUNTY, OREGON

PREPARED BY THE
OREGON STATE HIGHWAY DIVISION
IN COOPERATION WITH
U.S. DEPARTMENT OF TRANSPORTATION
FEDERAL HIGHWAY ADMINISTRATION

November 1974
Population 420

SCALE

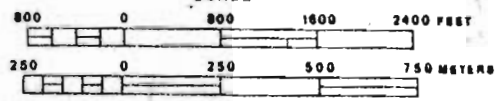

Copies of this map are available at nominal cost from Oregon State Highway Division, Salem, Oregon, 97310