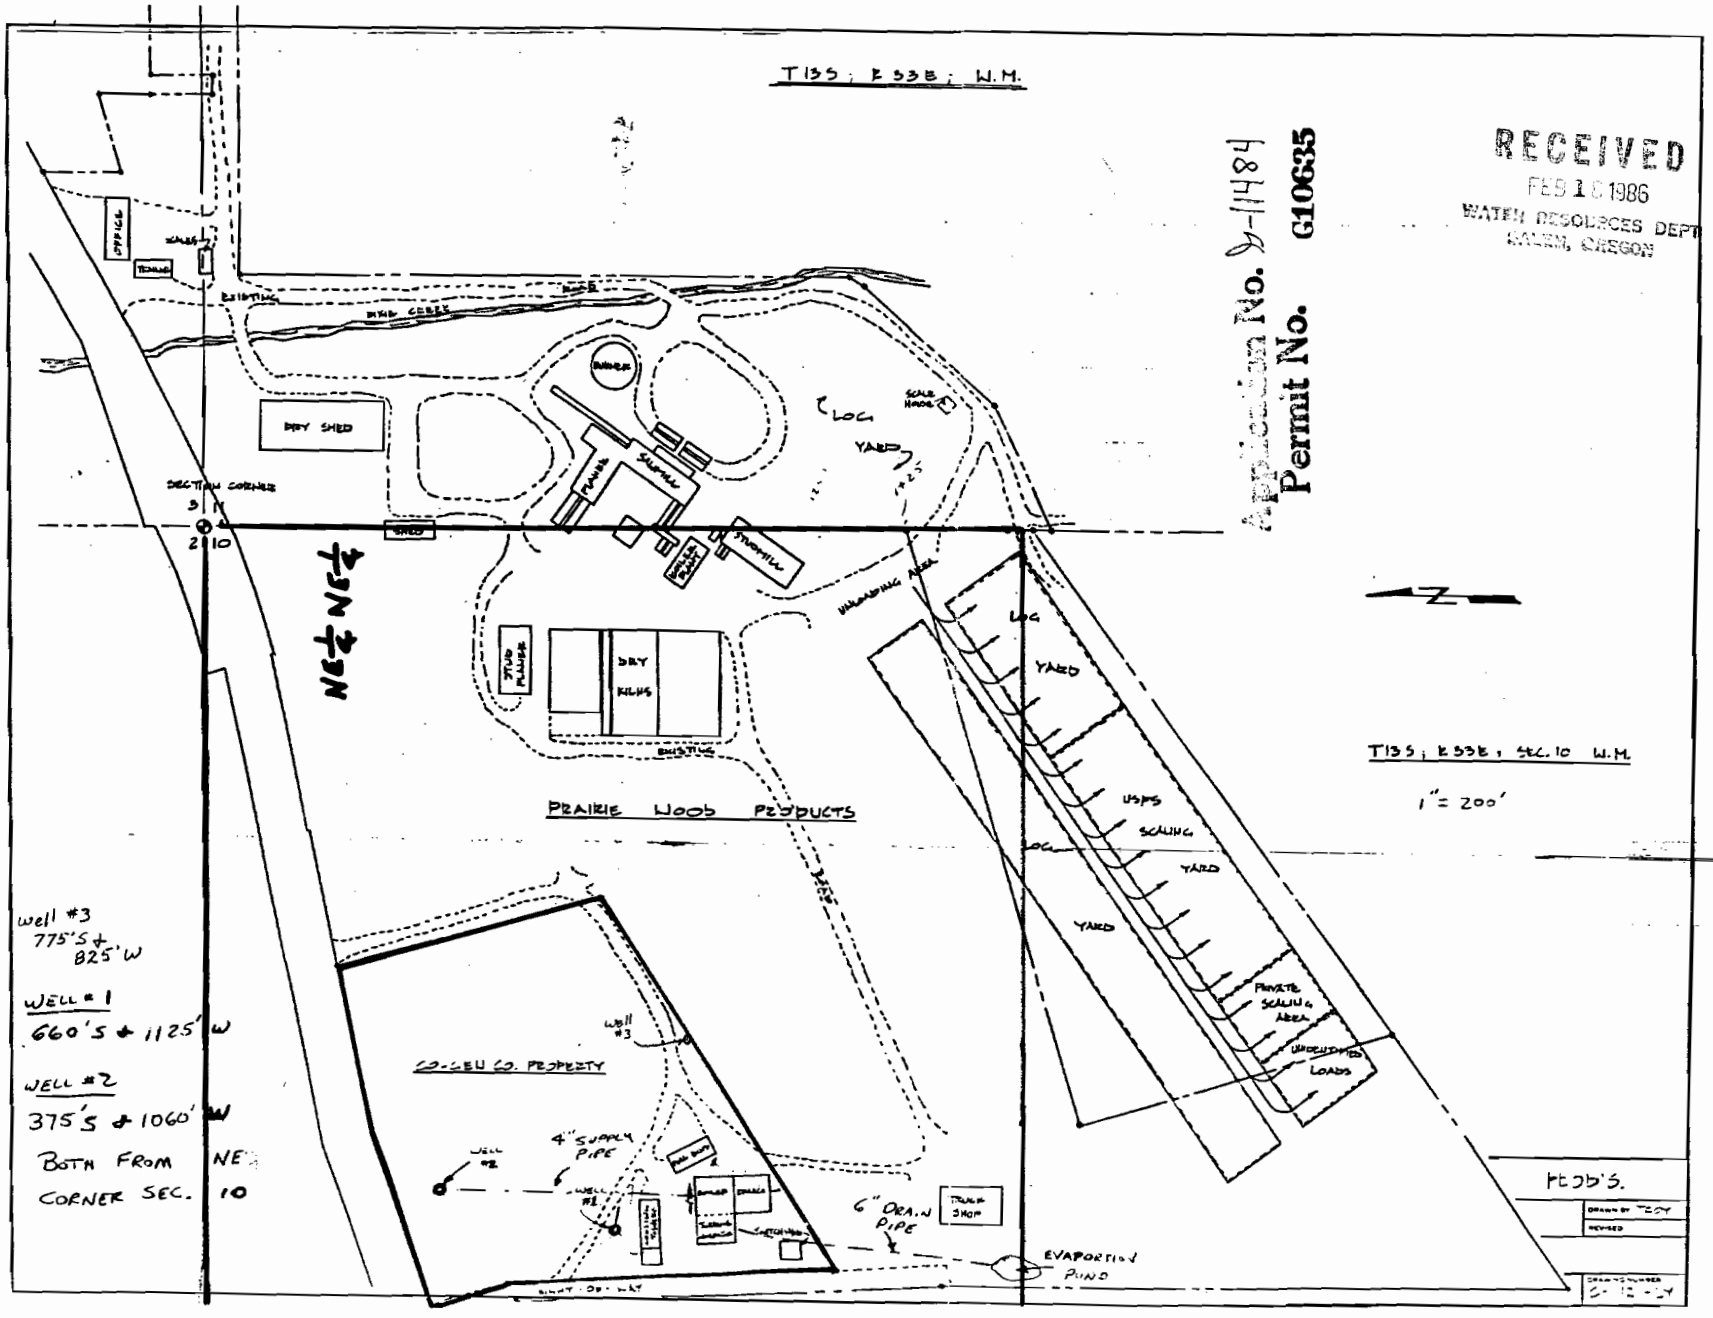
T13S; R33E; W.M.
Application No. 9-11484
Permit No. G10635
RECEIVED
FEB 10 1986
WATER RESOURCES DEPT
SALEM, OREGON
OFFICE
SCALES
TOILET
EXISTING
MILL CREEK
BARKER
DRY SHED
SCALE HOUSE
LOG YARD
SECTION CORNER
3 11
2 10
SHED
PLANER
SAWMILL
SHAVER PLANT
STUDMILL
UNLOADING AREA
NE¼ NE¼
STUD PLANER
DRY KILNS
EXISTING
PRAIRIE WOOD PRODUCTS
LOG YARD
USFS SCALING YARD
LOG YARD
PRIVATE SCALING AREA
UNDETERMINED LOADS
CO-GEN CO. PROPERTY
well #3
775'S + 825'W
WELL #1
660'S + 1125'W
WELL #2
375'S + 1060'W
BOTH FROM NE CORNER SEC. 10
WELL #3
WELL #2
WELL #1
4" SUPPLY PIPE
6" DRAIN PIPE
TRUCK SHOP
EVAPORATION POND
T13S; R33E; SEC. 10 W.M.
1" = 200'
PROPOSED
DRAWN BY
REVISED
DRAWING NUMBER