T13S R33E

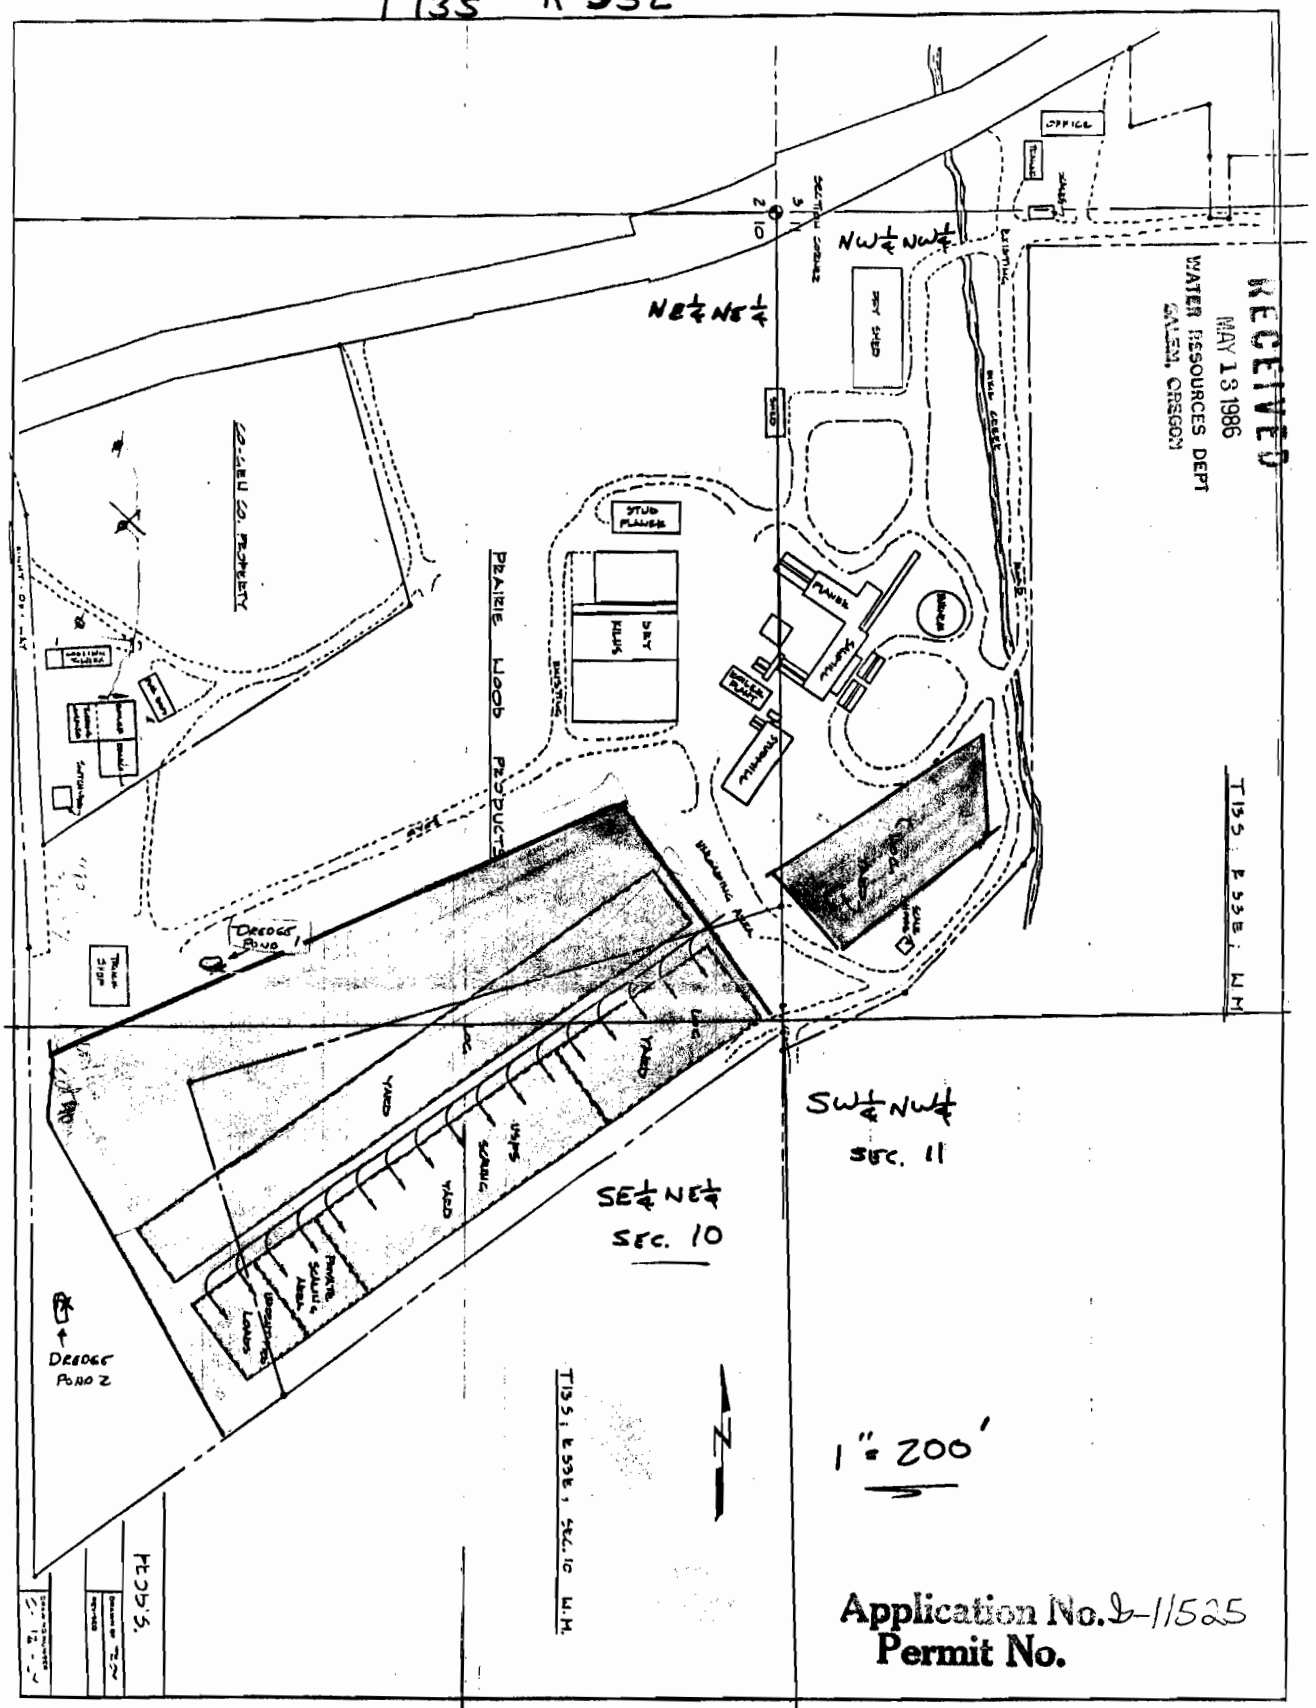

RECEIVED
MAY 13 1986
WATER RESOURCES DEPT
SALEM, OREGON

Application No. S-11525
Permit No.

#1 1215' S & 920' W

#2 1770' S & 1115' W

BOTH FROM NE CORNER OF SECTION 10