


T.8S., R.19E., W.M.

**RECEIVED**

AUG 21 1986

WATER RESOURCES DEPT.  
SALEM, OREGON

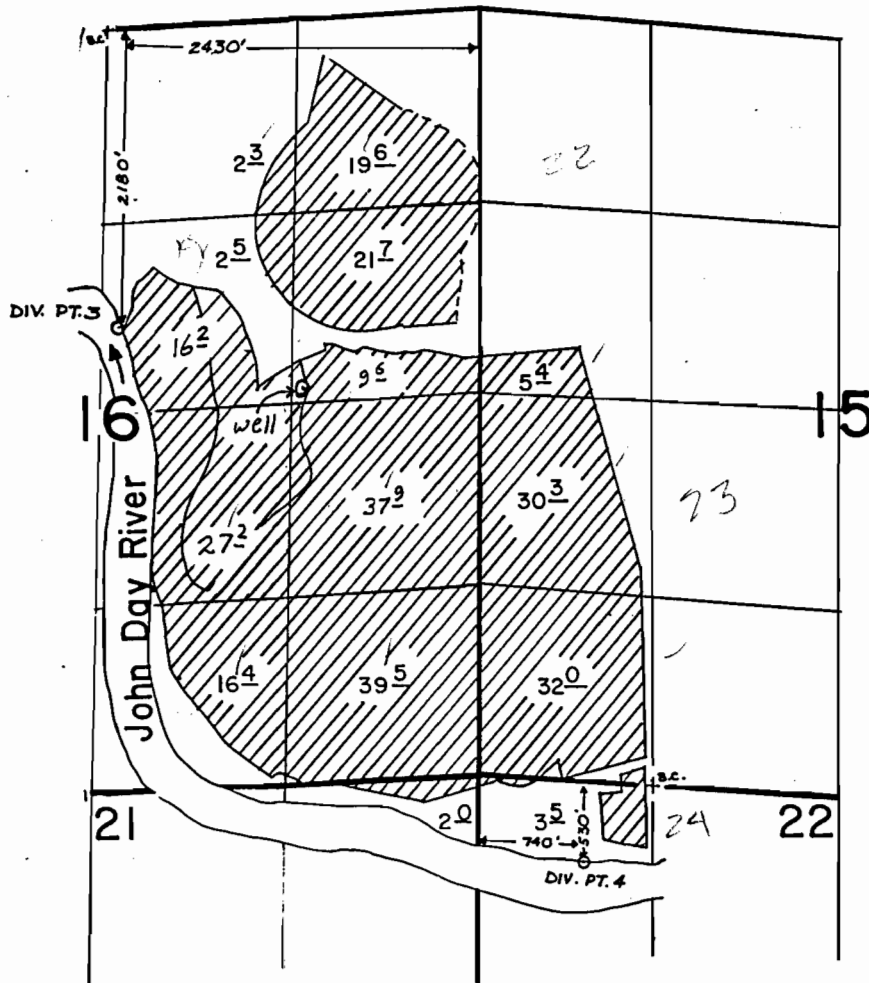

Well is located 2600'S & 1200'W from NE corner of Section 16

Application No. G-10957  
Permit No. G10642