

MAP TO ACCOMPANY WATER RIGHT APPLICATION
SITUATED IN GOV. LOTS 3, THRU 11, SEC. 19, T38S, R9EWM, KLAMATH COUNTY, OREGON

RECEIVED

JUL - 2 1986

WATER RESOURCES DEPT


SALEM, OREGON
EAST 2337 TO
NE COR SEC 19
(BY 1858 G.L.O. PLAT)

REGISTERED
PROFESSIONAL
LAND SURVEYOR

Erwin R. Ritter

OREGON
ERWIN R. RITTER
858

Application No. D-11550
Permit No. G10654

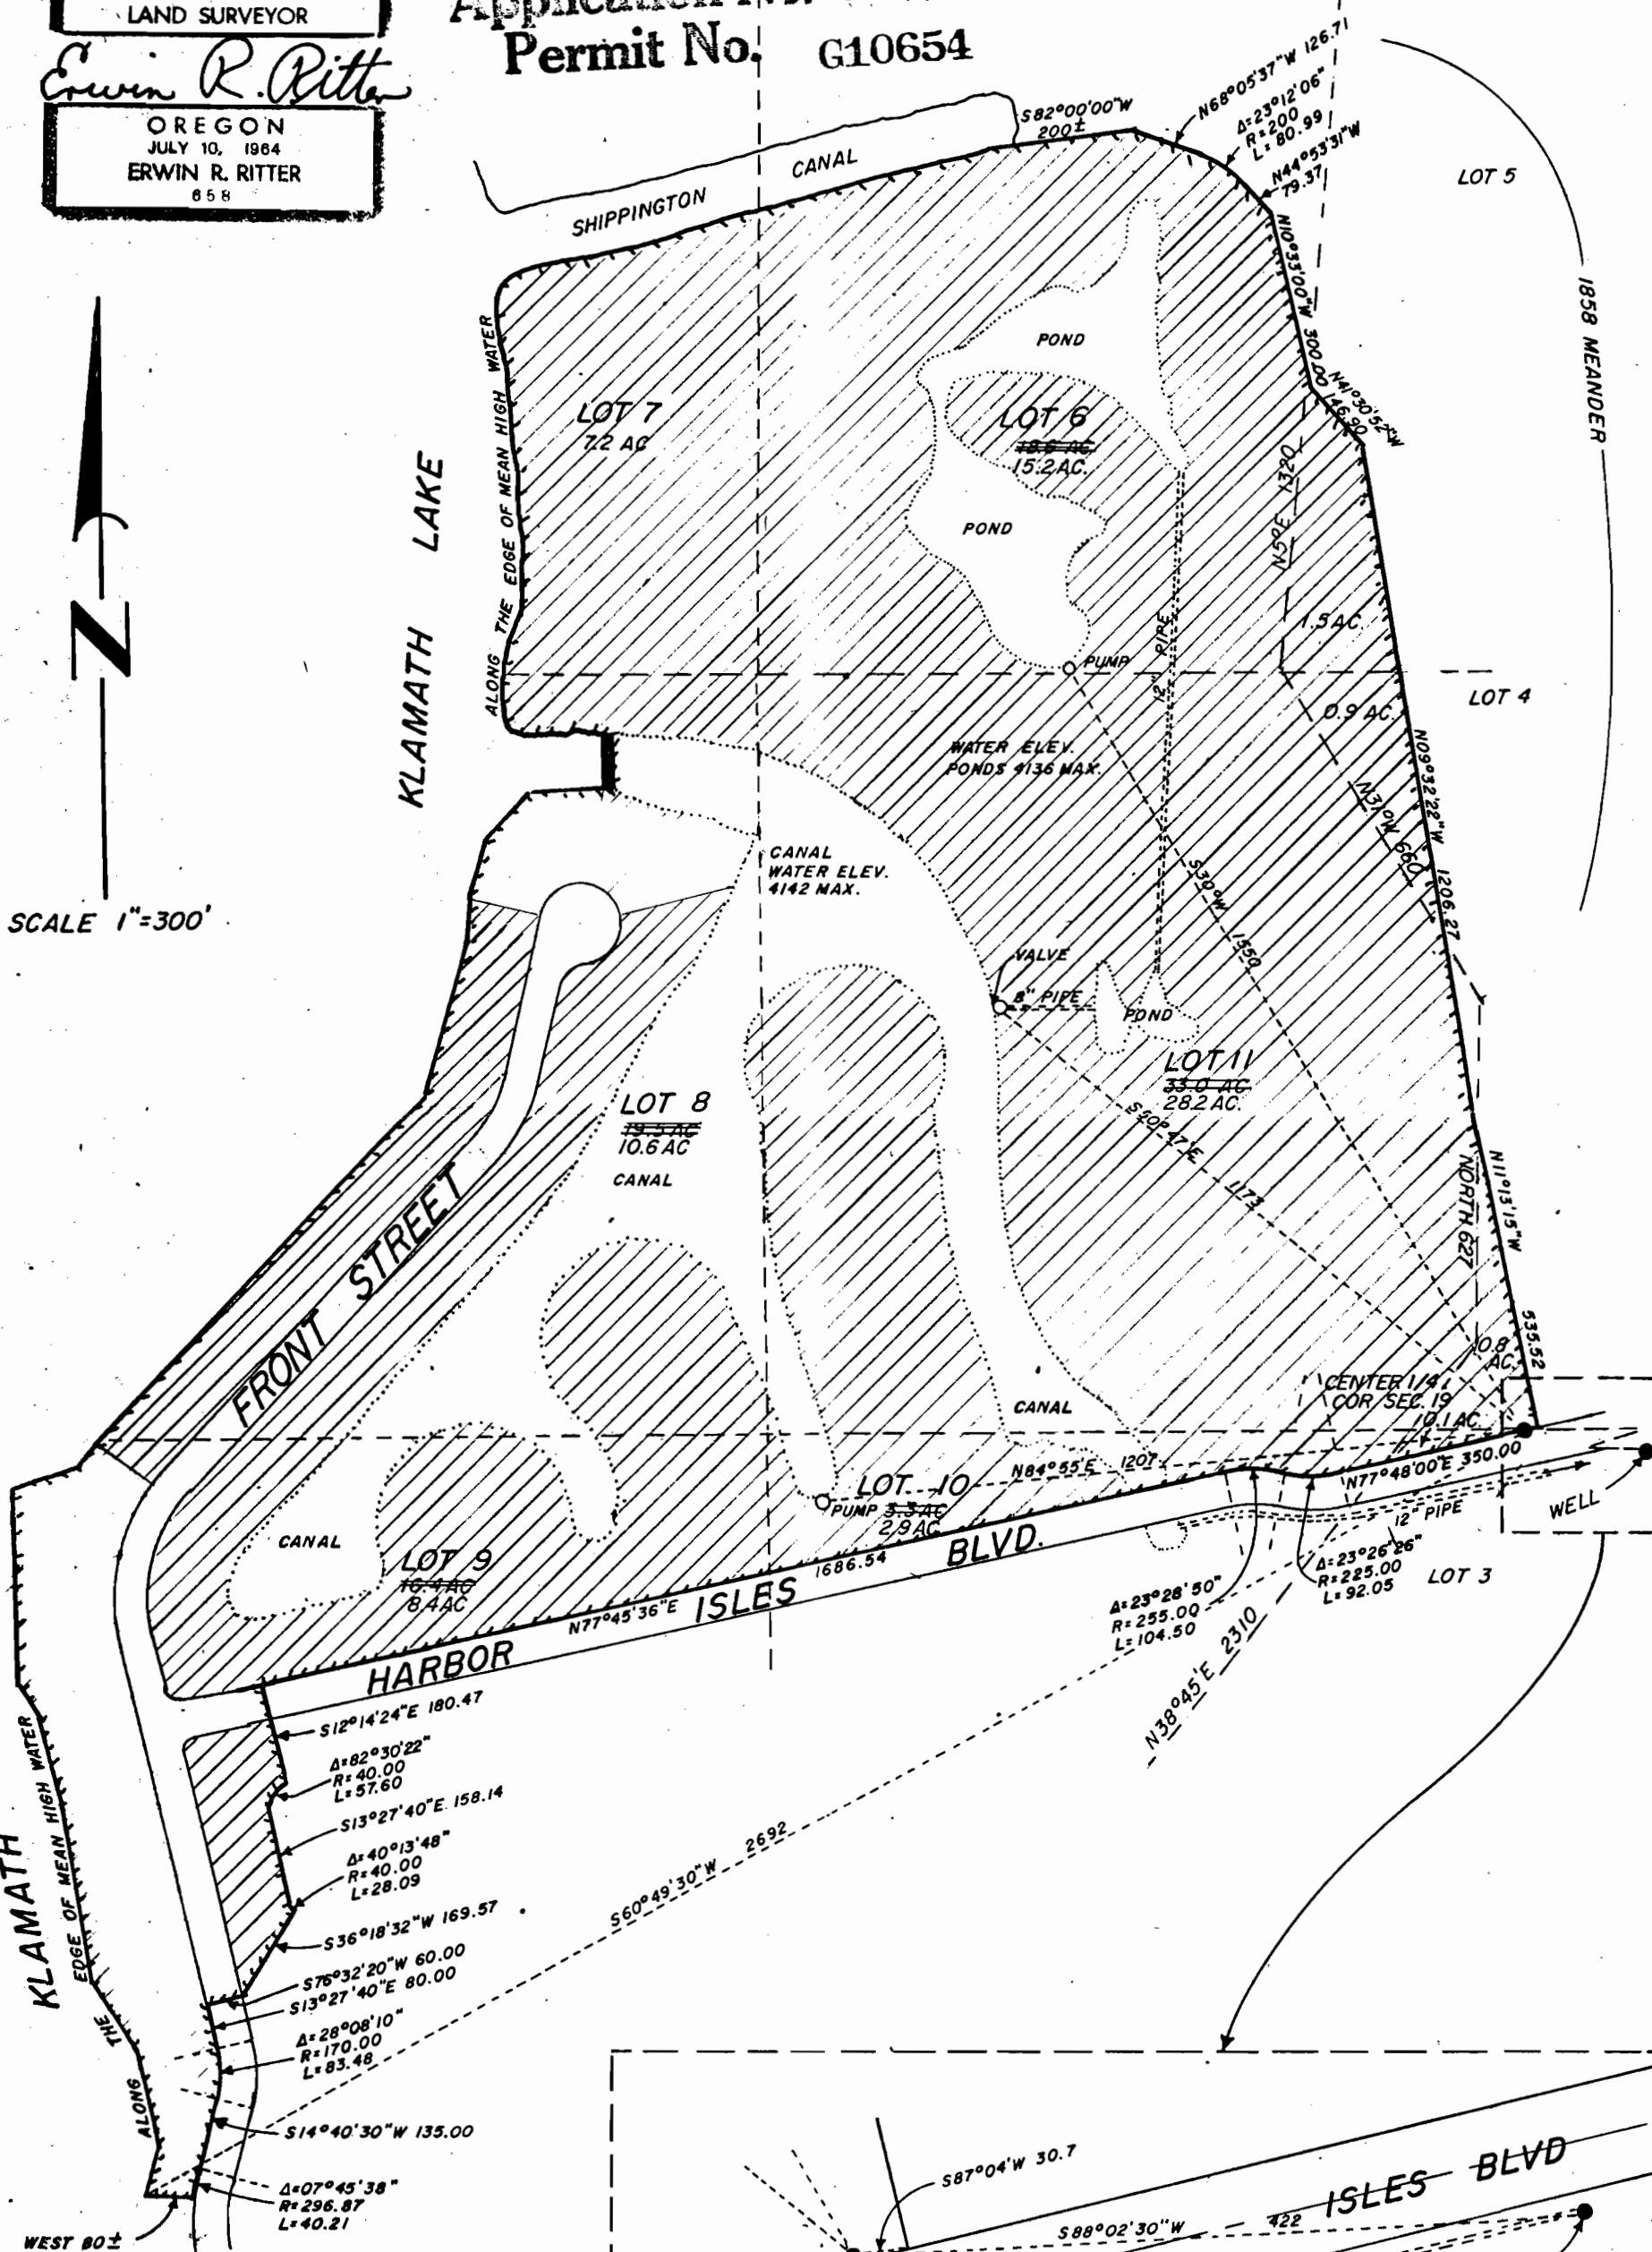

FROM THE OFFICE OF:

TRUSURVEYING LINE
2333 Summers Lane
Klamath Falls, OR 97603

Date: JUNE 1986

RECEIVED

AUG 11 1986

WATER RESOURCES DEPT
SALEM, OREGON