

T. 16 S., R. 11 E.

1" = 400'

Section 9


RECEIVED

JUN 13 1986

WATER RESOURCES DEPT
SALEM, OREGON

Application No. G-11540

Permit No. G10676

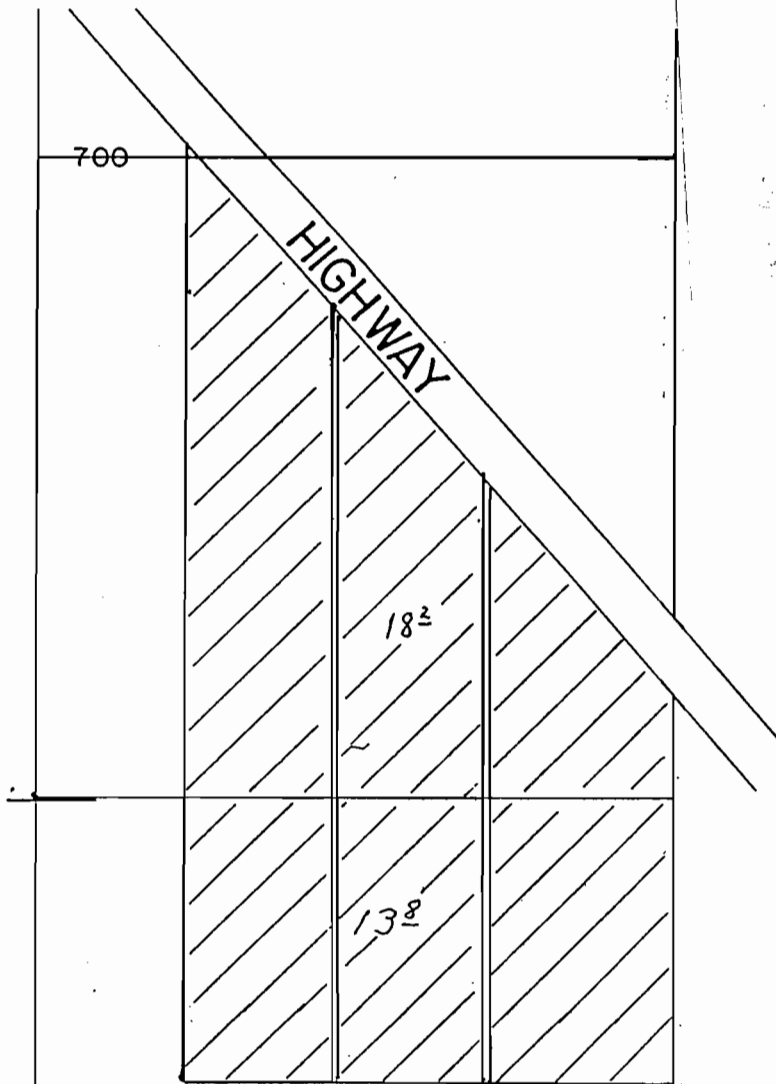

well ① ← 420' →

637'

9

10

SE corner
sec. 9

16

15