


RECEIVED

JAN 5 1987

WATER RESOURCES DEPT
SALEM OREGON

T.6S. R.1E.W.M.

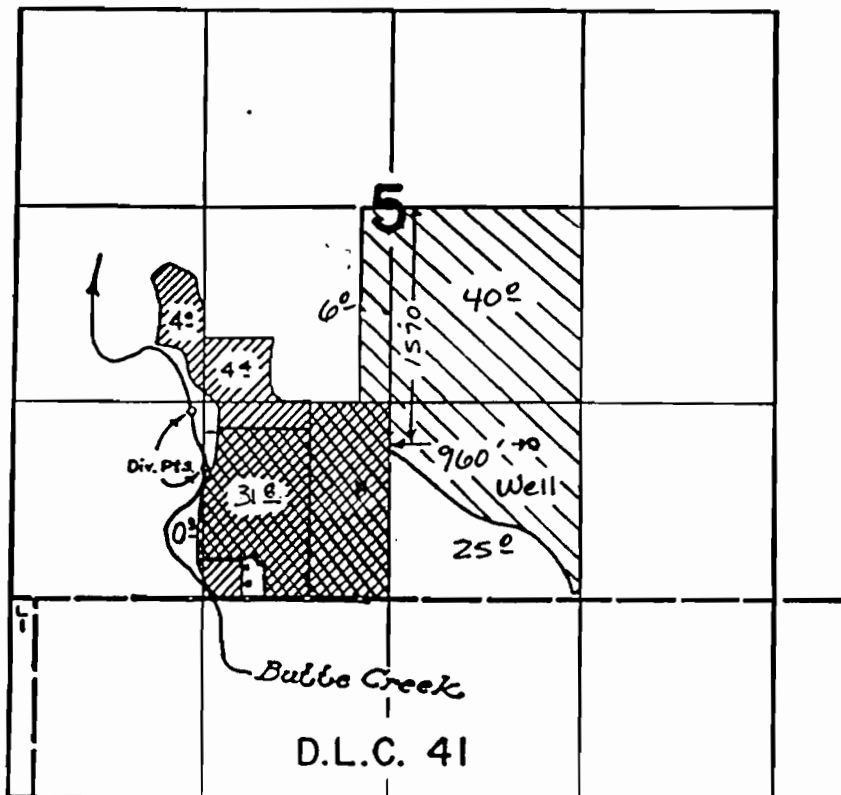

XXXXX Suppl
///// Primary

Application No. *9-11607*
Permit No. **G10683**

~~Application No. 31034 Permit No. 24396~~ //