


T.40S.,R.8W.,W.M.

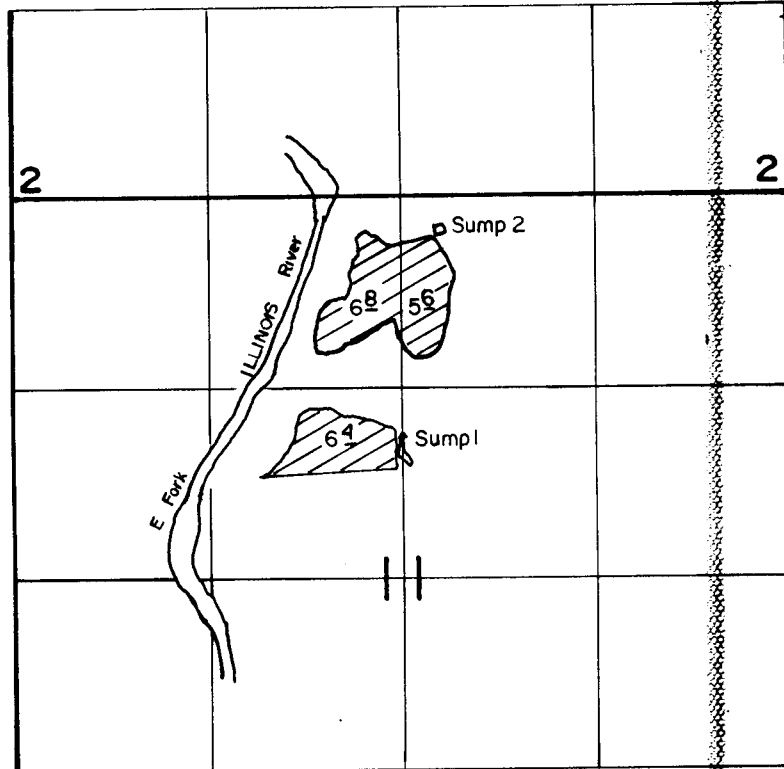

Sump1-1650' S, Sump2-220'S&250'E,Both From N1/4 Corner Of Section 11

SCALE: 1"=1320'

MAY 22 1991

GRANTS PASS, ORE

FINAL PROOF SURVEY UNDER

Application No. G-11537... Permit No. G-10685...
IN NAME OF

.....JOHN.....P.....JARNAGIN.....

Surveyed MAY.22.. 1990., by B.S.JAMES.....