


Application No. C-11037  
Permit No. G10702

T-24-S  
1" = 1320'  
4" = 1 MILE

R-27-E  
R-28-E

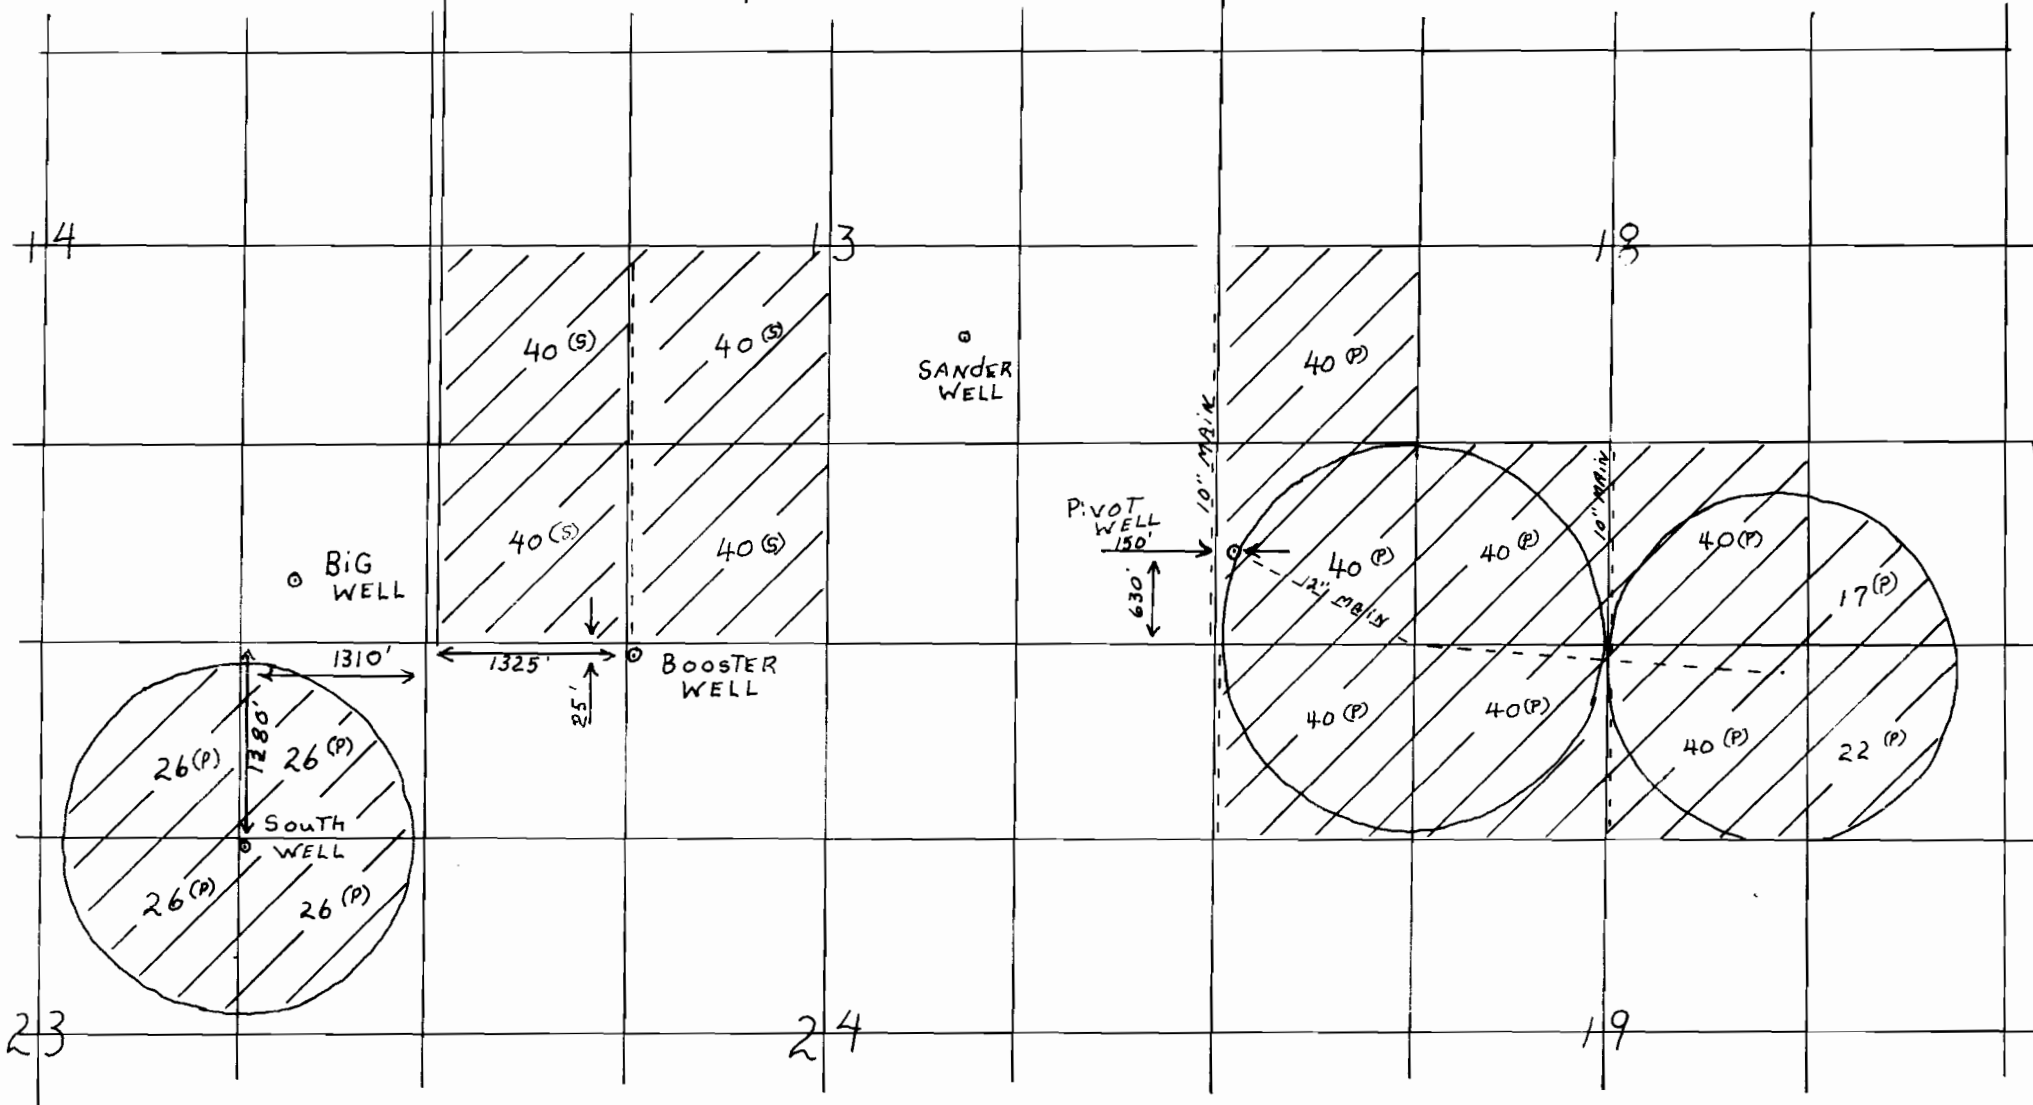

RECEIVED  
JUL 25 1993  
WATER RESOURCES DEPT.  
SALEM, OREGON