

SECTION PLAT


Section 6 Township 25-S Range 34-E

County of HARNEY State of OREGON

RECEIVED

SEP 18 1986

WATER RESOURCES DEPT
SALEM, OREGON

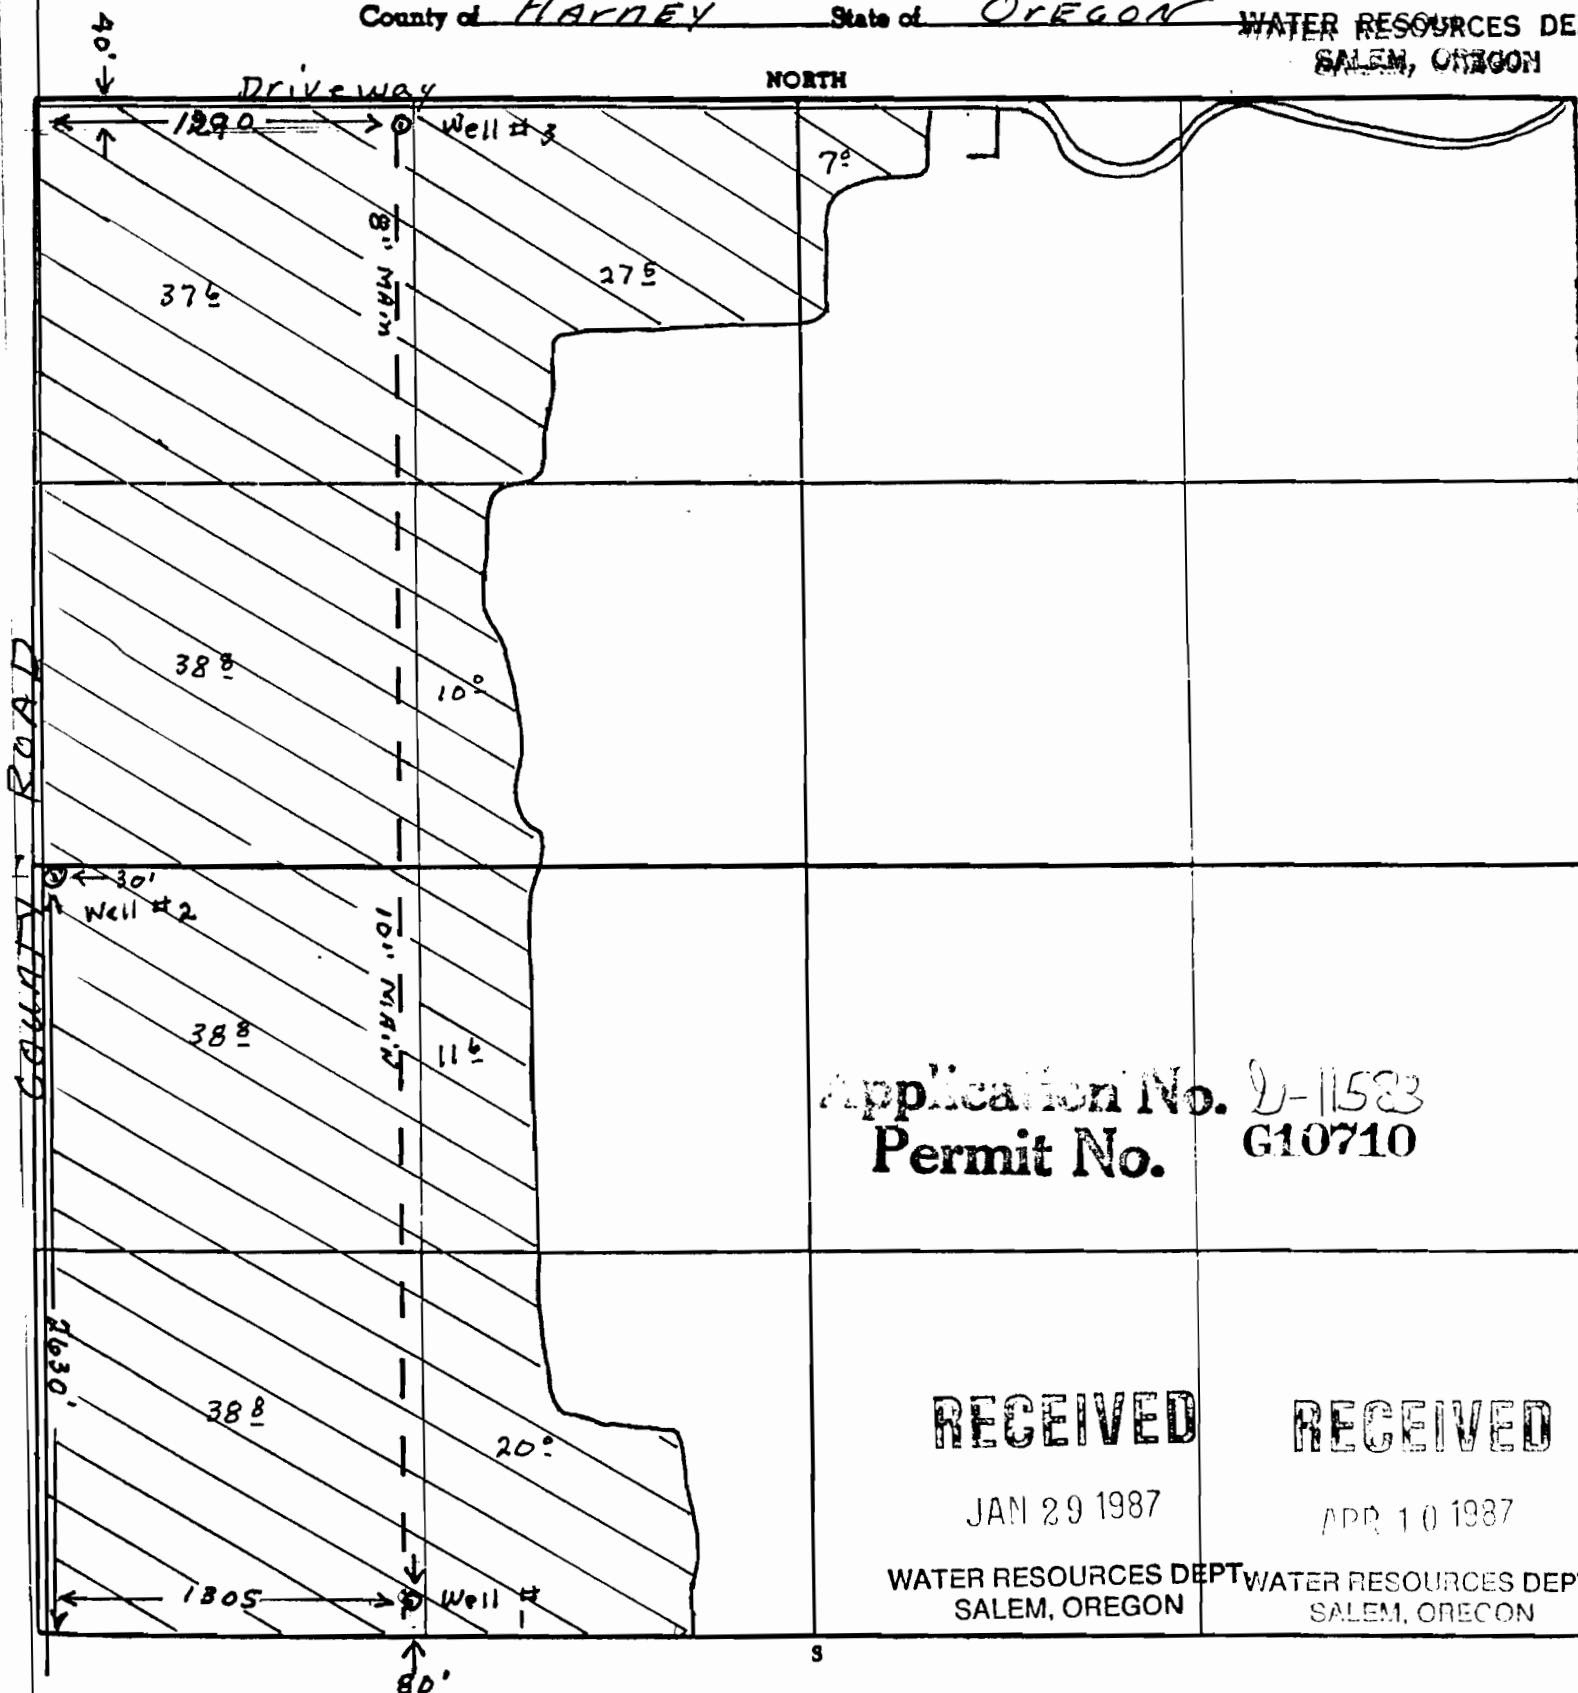

Application No. D-11523
Permit No. G10710

RECEIVED

JAN 29 1987

WATER RESOURCES DEPT
SALEM, OREGON

RECEIVED

APR 10 1987

WATER RESOURCES DEPT
SALEM, OREGON

Remarks scale - 8" = 1 mile - 660' -