


RECEIVED

FEB 12 1987

**WATER RESOURCES DEPT
SALEM OREGON**

T.27S. R.13E.

*1
1
2*

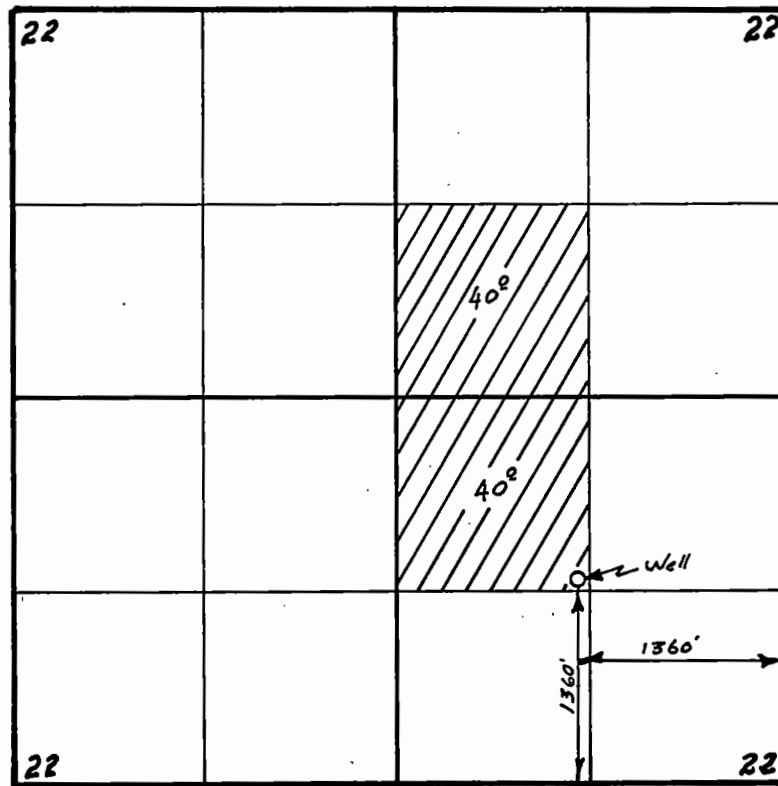

Scale - 1/4" = 1 mi.

This map prepared from information furnished
by APPLICANT _____

Application No. G-11000

Permit No. G10712