


T. 27 S. R. 6 W.

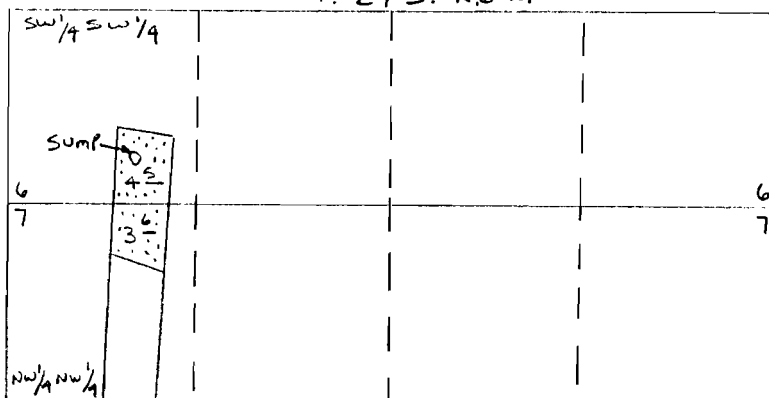

1" = 1 MILE

Sump = 300' N. & 850' E. From SW cor. S. 6

Application No. 2-11625  
Permit No. G10721