

RECEIVED


FEB 5 1987

WATER RESOURCES DEPT.
SALEM, OREGON

RECEIVED

MAY 8 1987

WATER RESOURCES DEPT.
SALEM, OREGON

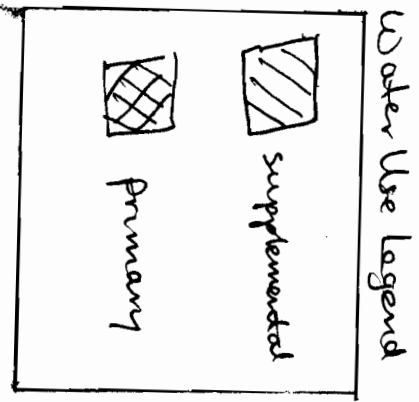


Application No. G-11532
Permit No. G10744

RECEIVED

NOV 28 1986

WATER RESOURCES DEPT.
SALEM, OREGON

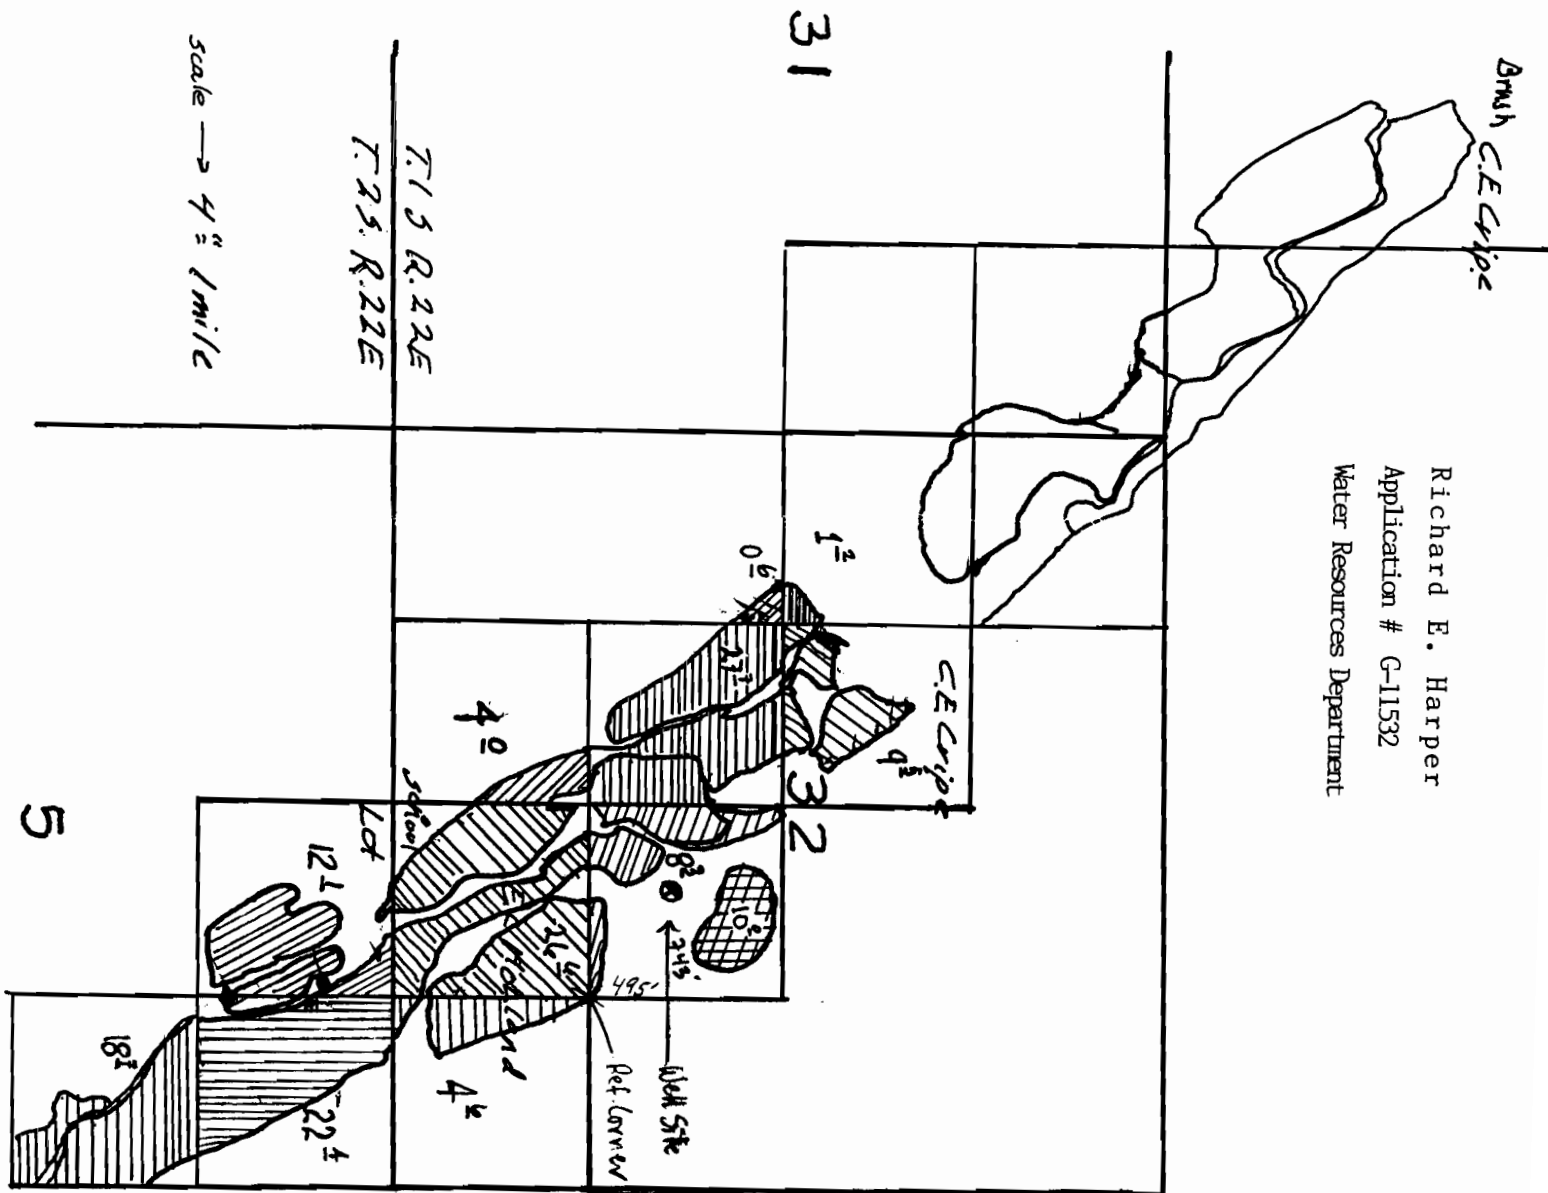

Richard E. Harper
Application # G-11532
Water Resources Department