


Application No. G-11548  
Permit No. G10745

24 | 19  
25 | 30

↙ 1/4 cor

**RECEIVED**

JUN 0 1986  
WATER RESOURCES DEPT  
SALEM, OREGON

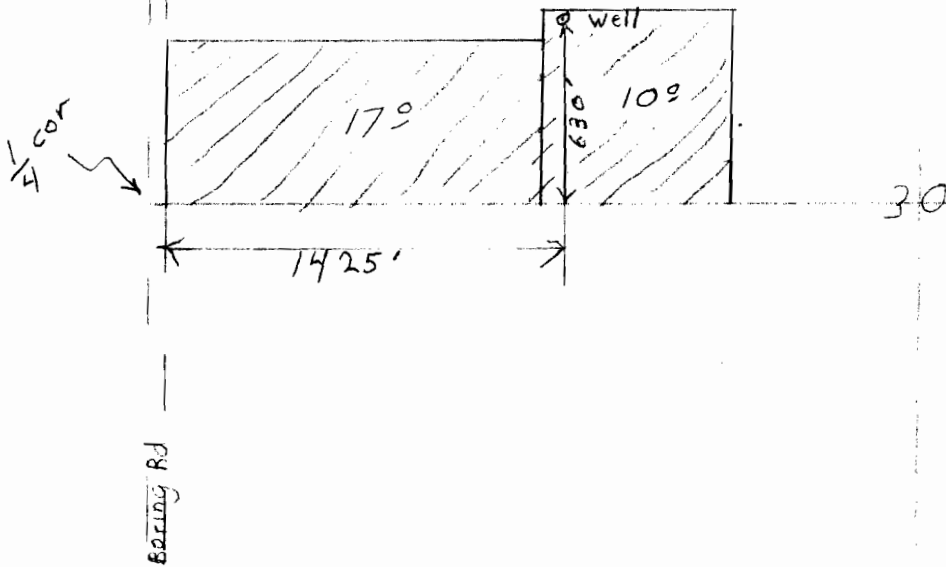

Twp 15 Rge 4E

Scale 1" = 660'

25 | 30  
36 | 31