


T. 37 S., R. 6 W., W. M.

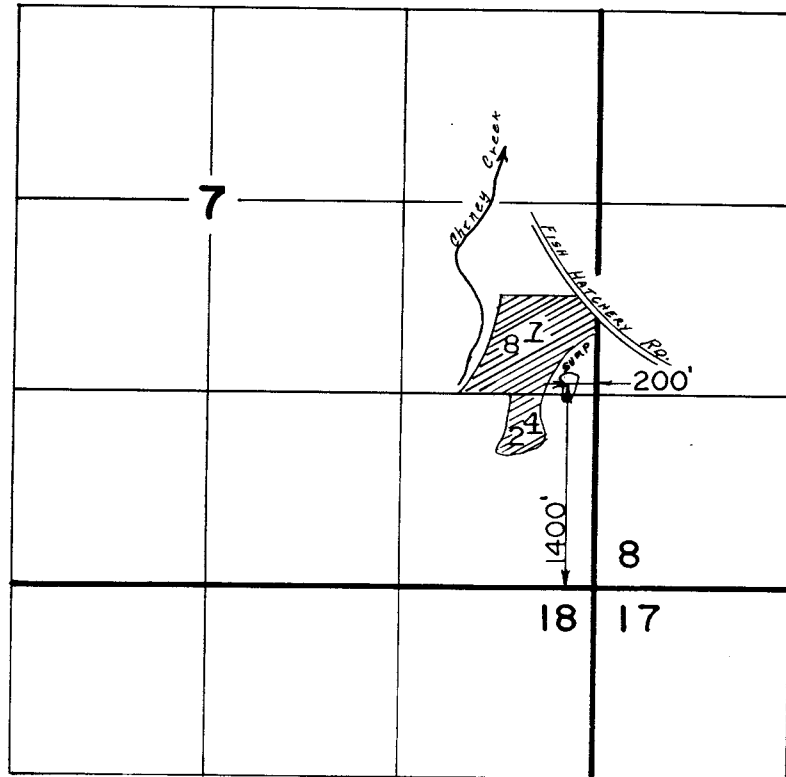

Scale: 1" = 1320'

FINAL PROOF SURVEY
UNDER

Application No. G-11582 Permit No. G-10746
IN NAME OF

RONALD GEORGE MASTEL & KAREN ANN STEVENS MASTEL

Surveyed AUG. 29. 1988, by B. S. JAMES...

B.50-2-10 LMS
2/89