

RECEIVED


MAY 18 1987

WATER RESOURCES DEPT.
SALEM, OREGON



Sec. 29 T.6N. R.35E.W.M.
UMATILLA COUNTY

1" = 400'

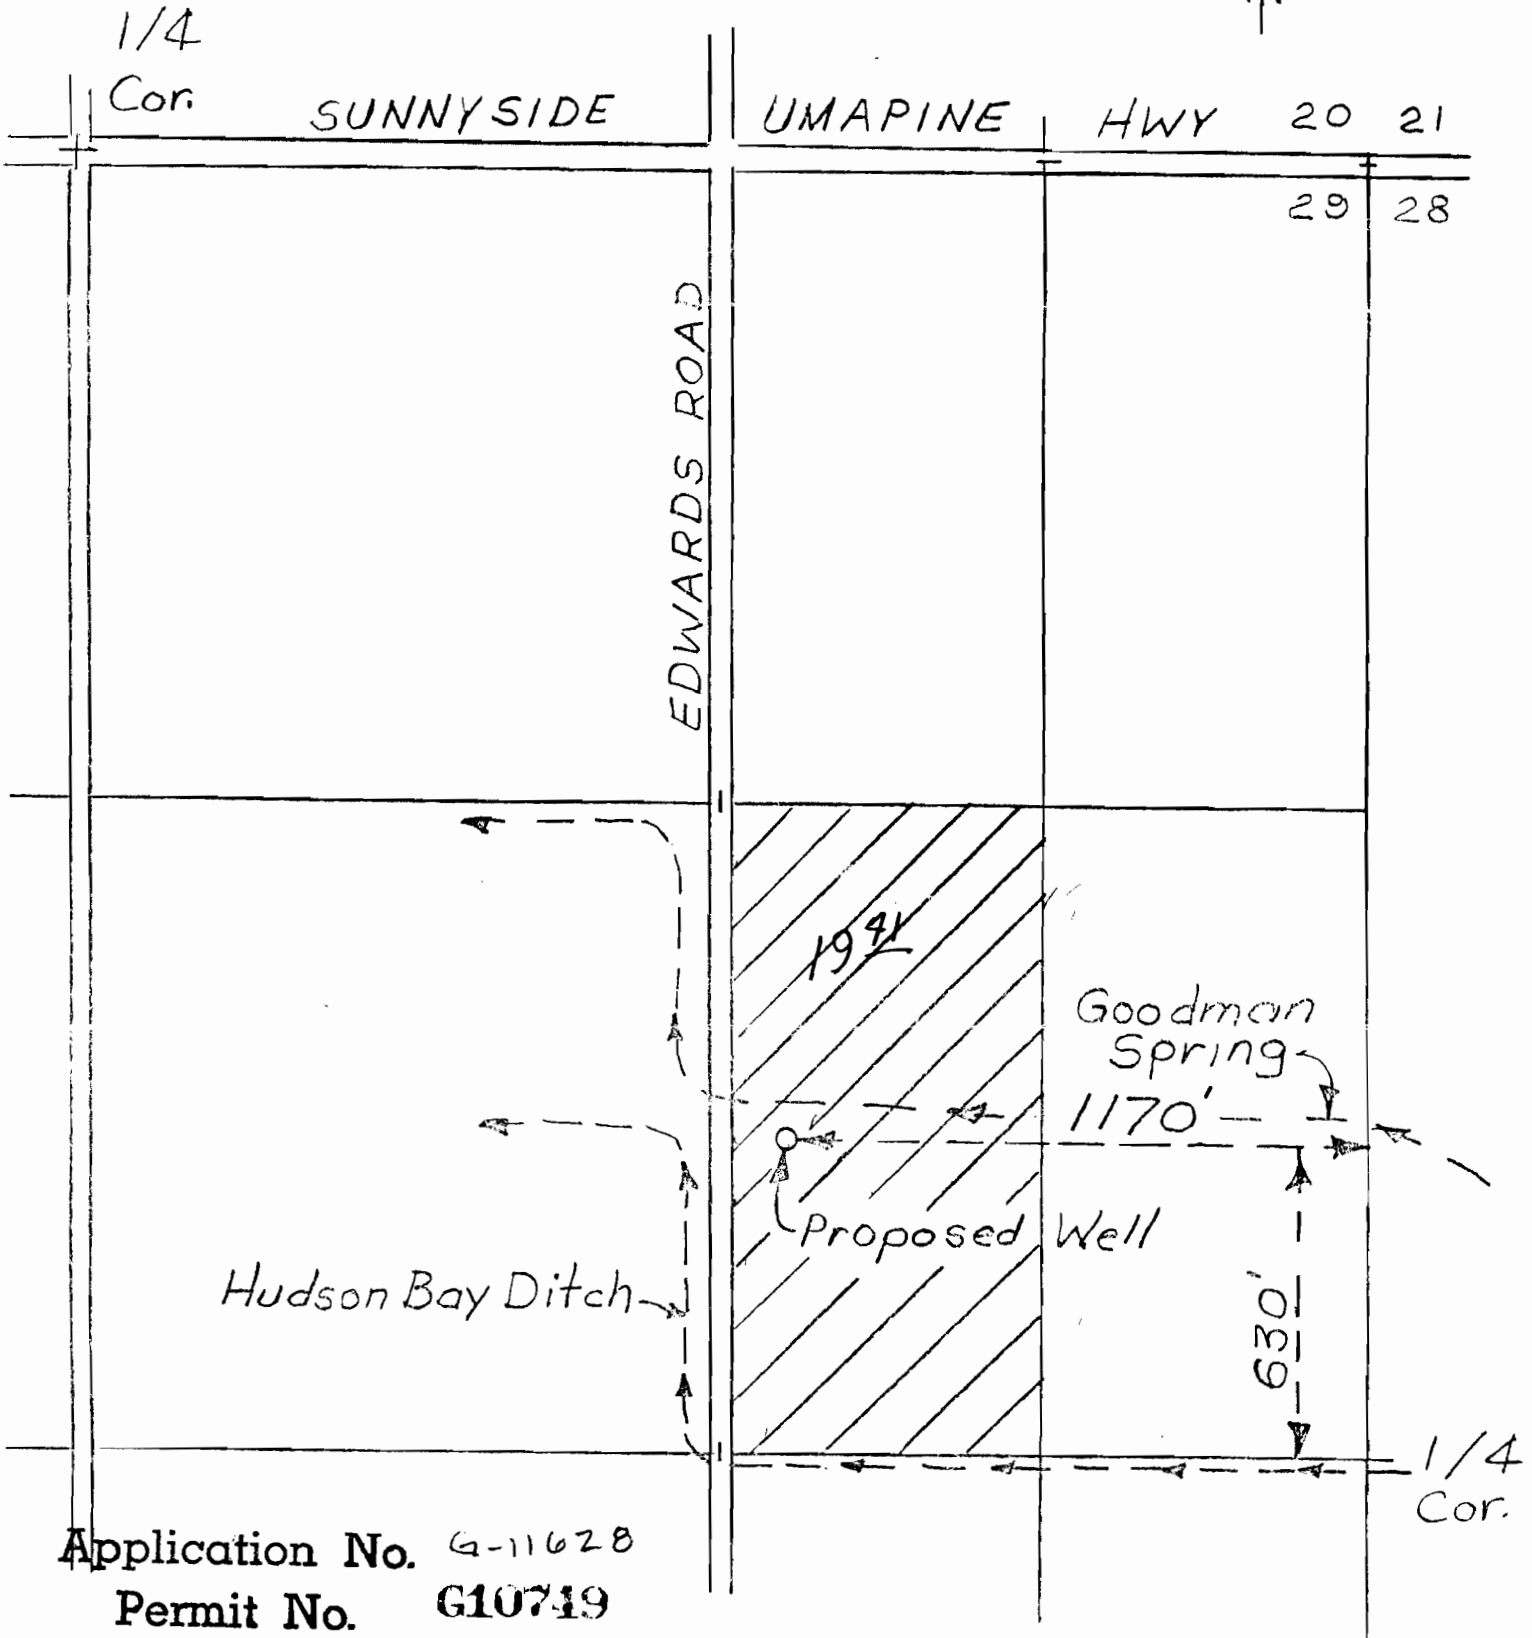

Application No. G-11628

Permit No. G10719