

SILVER LAKE RANGER STATION

RECEIVED

2.0 Acres
Irrigated

TOWNSHIP 28S, RANGE 14E, W. M.
NW 1/4 SE 1/4 Section 21
SW 1/4 SE 1/4 North

RECEIVED JAN 29 1987
WATER RESOURCES DEPT.
SALEM, OREGON
JUN 5 - 1987


WATER RESOURCES DEPT.
SALEM, OREGON
RECEIVED

NOV 23 1987

WATER RESOURCES DEPT.
SALEM, OREGON

FEB - 8 1994

WATER RESOURCES DEPT.
SALEM, OREGON

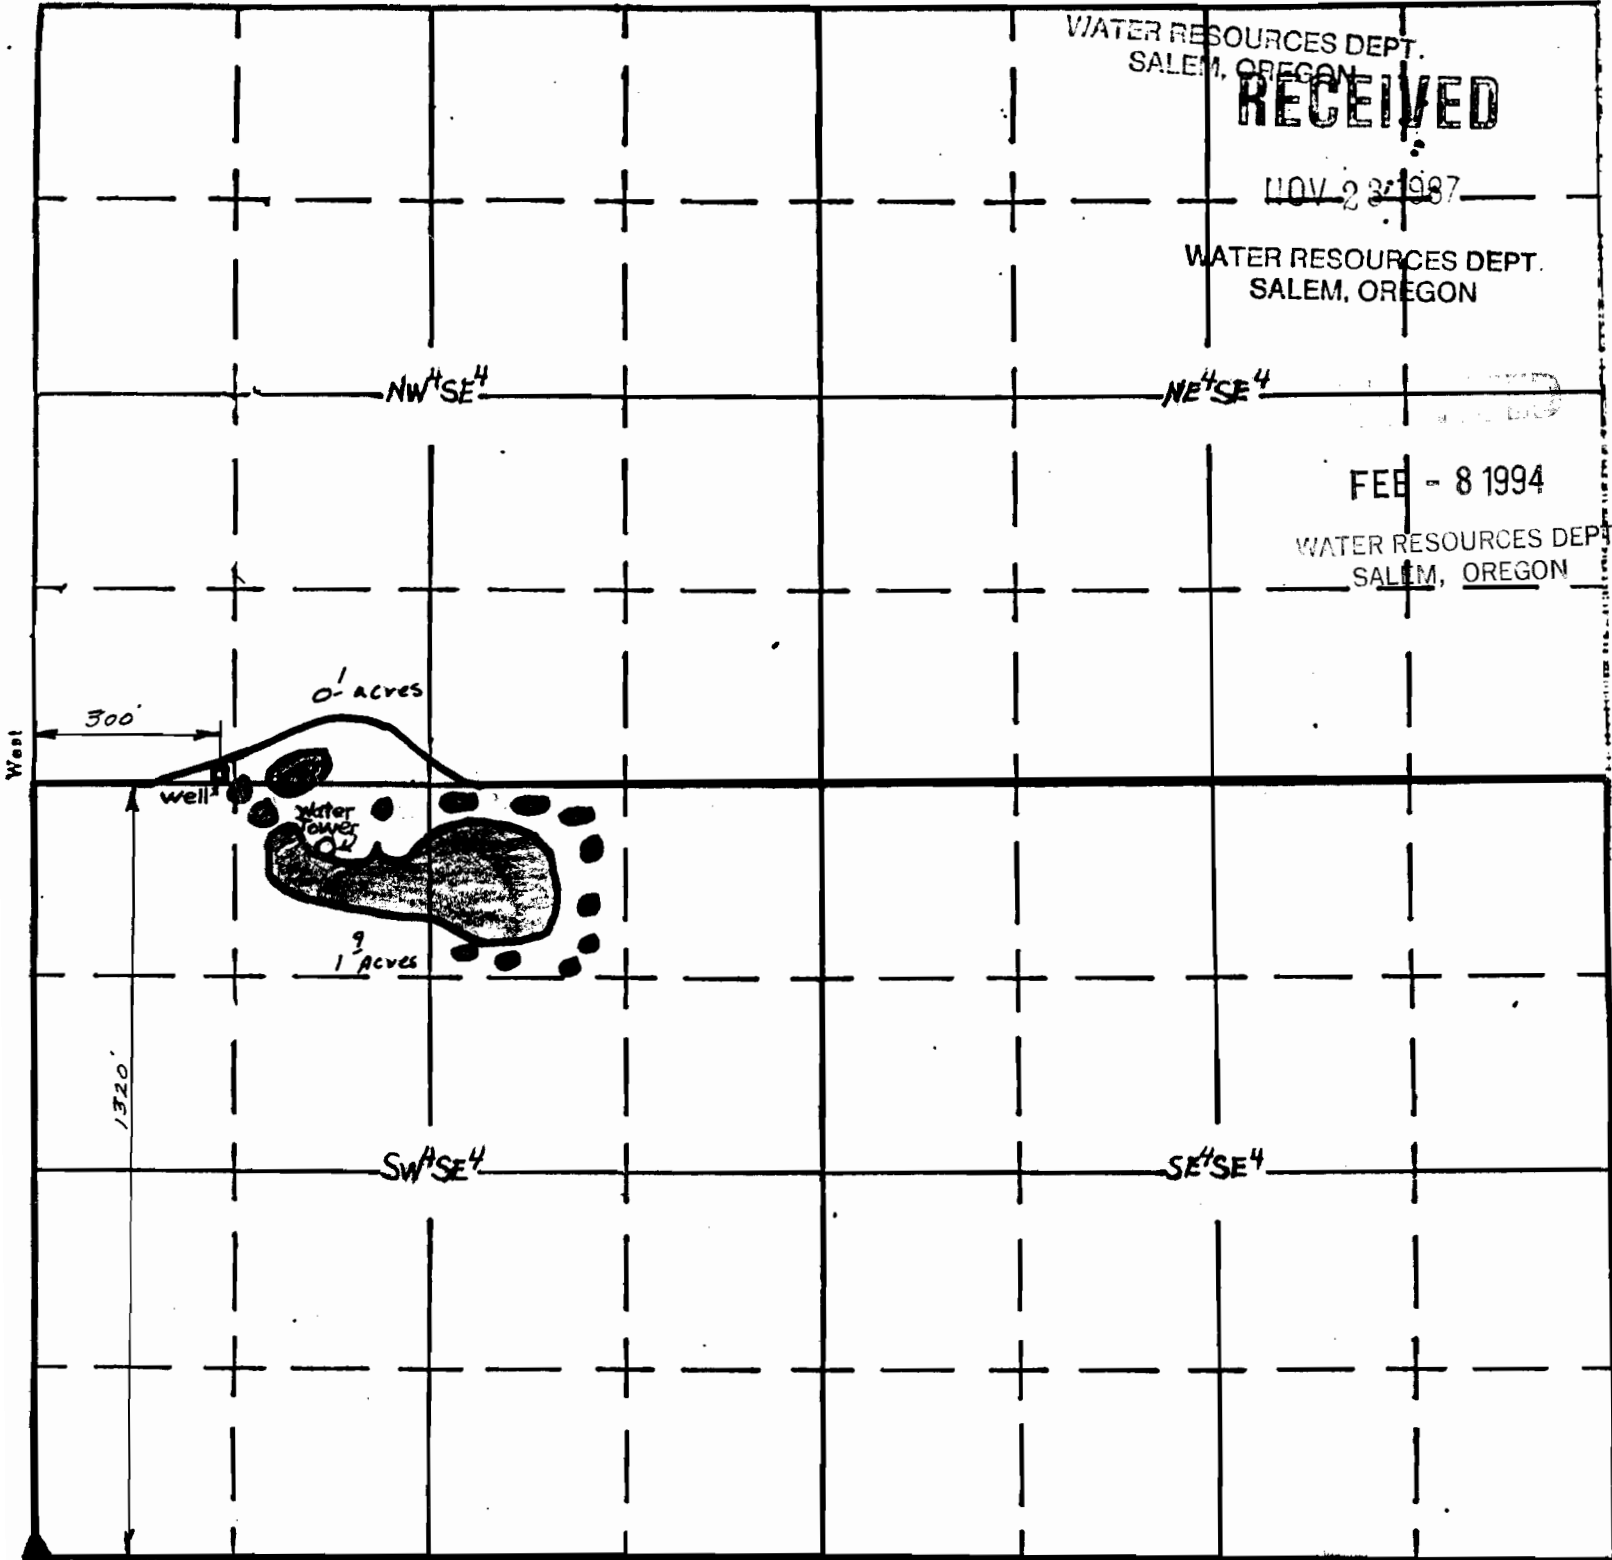

APPLICATION No. 2-11617
PERMIT No.
G10784

● Area Irrigated 2.0 acres

8" = 1/2 mile