


JOSEPHINE COUNTY

1" = 200'

E MAP 36 6 23A

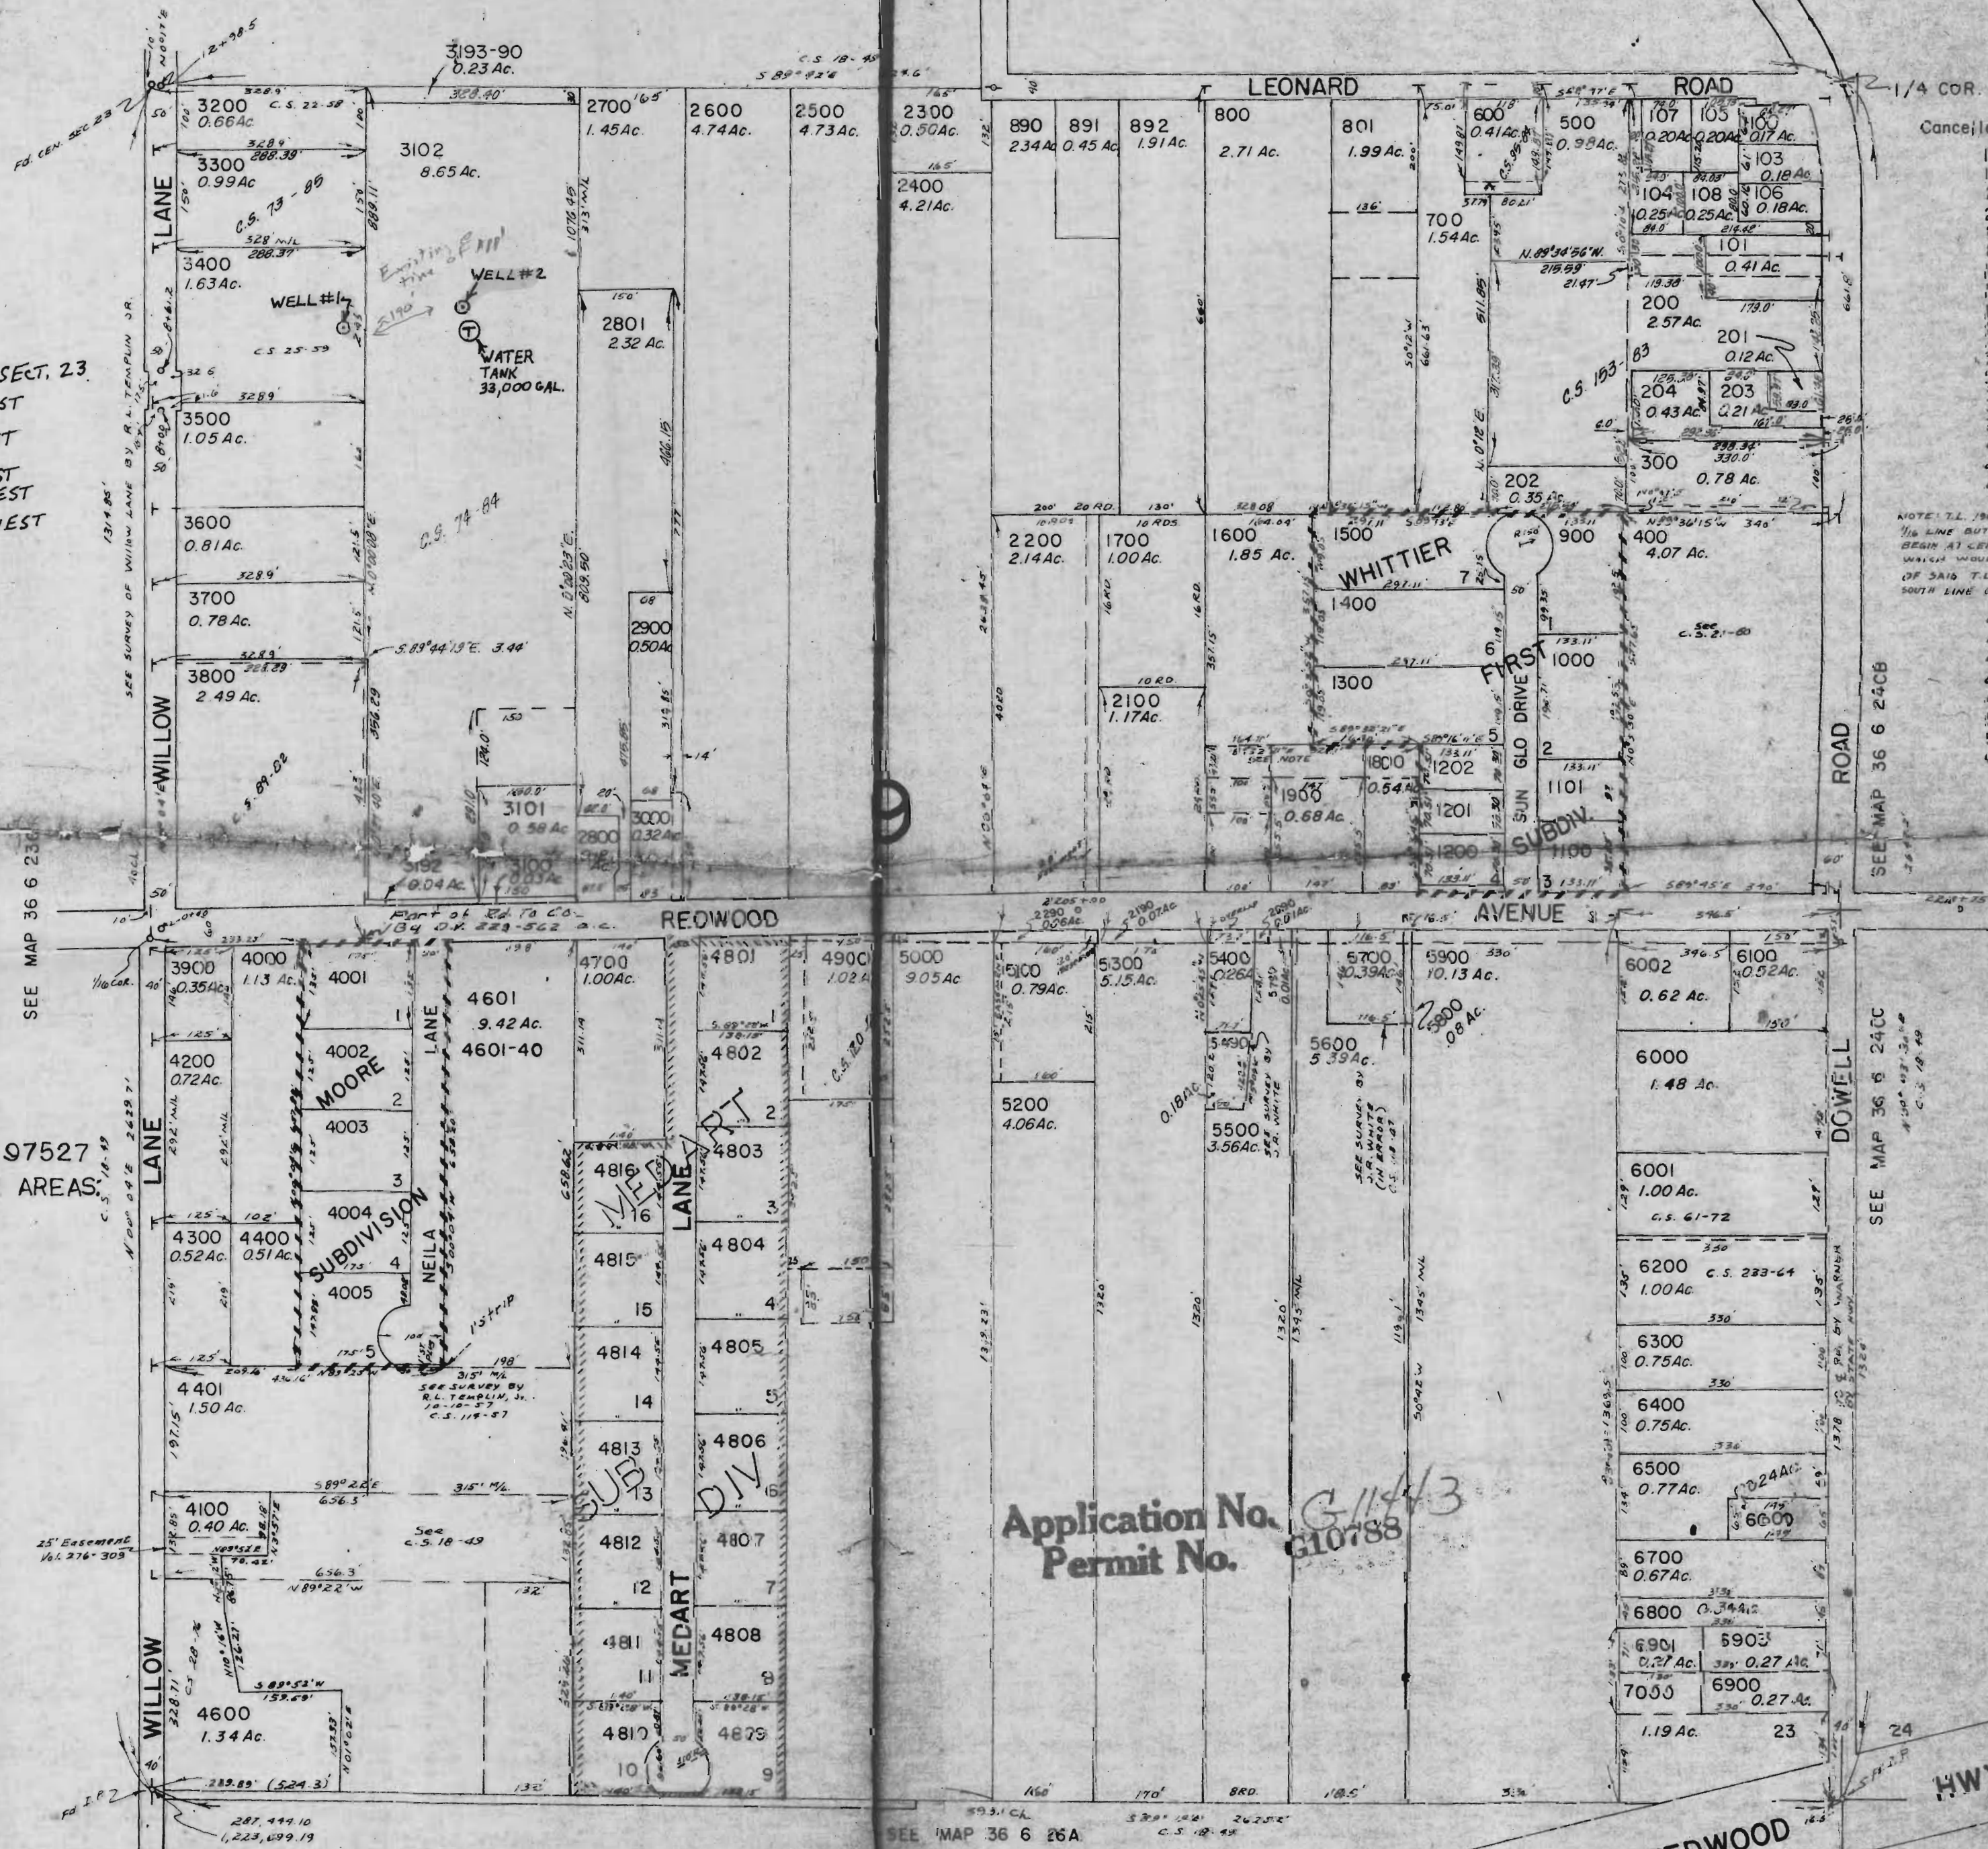

Cancelled Tax Lots

102
190
290
291
893
894
1801
1802
1803
2000
2490
2590
3190
3191
3790
4006
4107
4900
4402
4500
4800
4990
4991
5001
5801
6902

DISTANCES FROM C¹/₄ CORNER SECT. 23

WELL NO. 1 - 375' SO. & 300' EAST

WELL NO. 2 - 340' SO. & 473' EAST

WELL NO. 3 - 150' NO. & 355' EAST

WELL NO. 4 - 625' NO. & 286' WEST

WELL NO. 5 - 465' NO. & 161' WEST

RONALD C. NUNN
3853 LEONARD ROAD
GRANTS PASS, OREGON 97527

PROPOSE WATER SERVICE AREAS:

TL 2700
TL 3102
TL 3300
TL 3400
TL 3800
TL 2801

Application No. G-11443
Permit No. G10788

HWY.