

UNIT 001/4 SEC 22

Evergreen Parkway

Dawson Creek Dr.

21 22

NE 1/4 NE 1/4 SEC 28

NW 1/4 NE 1/4 SEC 28

NE 1/4 NW 1/4 SEC 28

245th Ct

28 27

N-S line


SE 1/4 NW 1/4 28

SW 1/4 NE 1/4 SEC 28

SE 1/4 NE 1/4 SEC 28

SW 1/4 NW 1/4 SEC 27

Dawson Creek Dr.

229.6'

245.6'


156.6'

791.4'

BOUNDARY




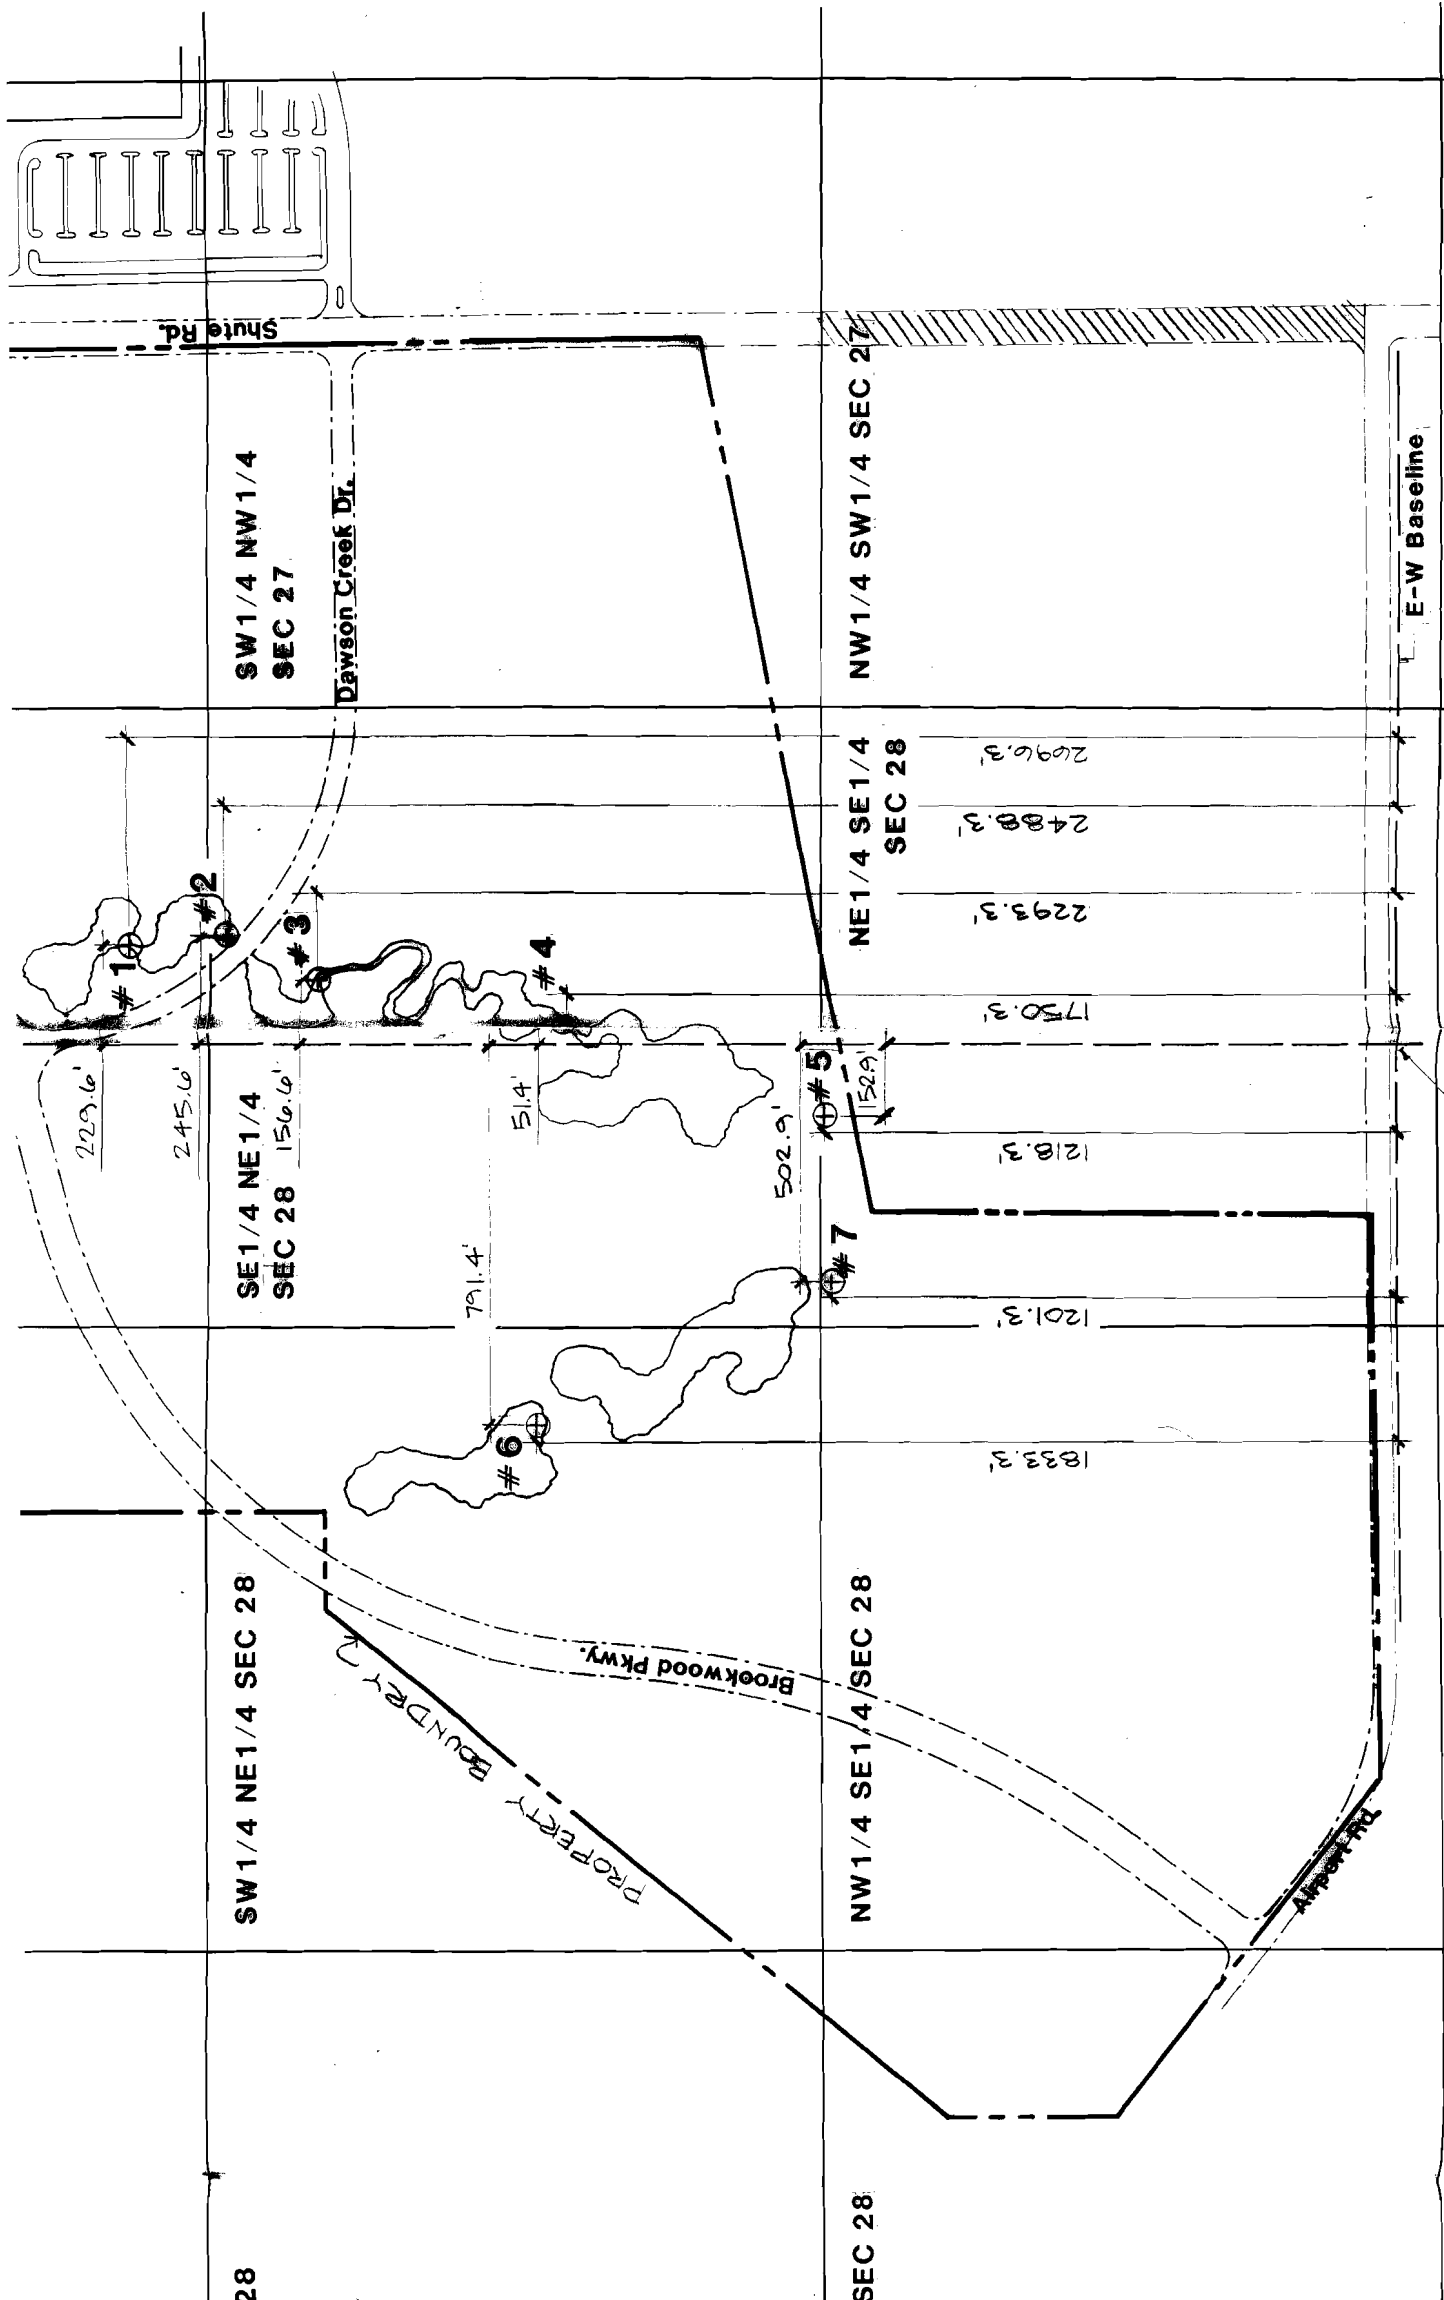

NW Corner DLC #45  
 N 90.717