
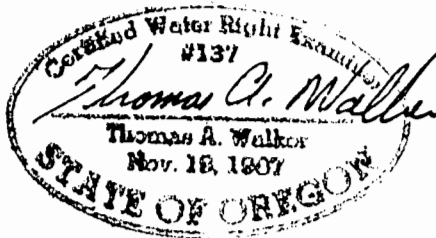


TOWNSHIP 35 RANGE 1W WM

1" = 1320'

Application No. G-11829

Permit No. G10830

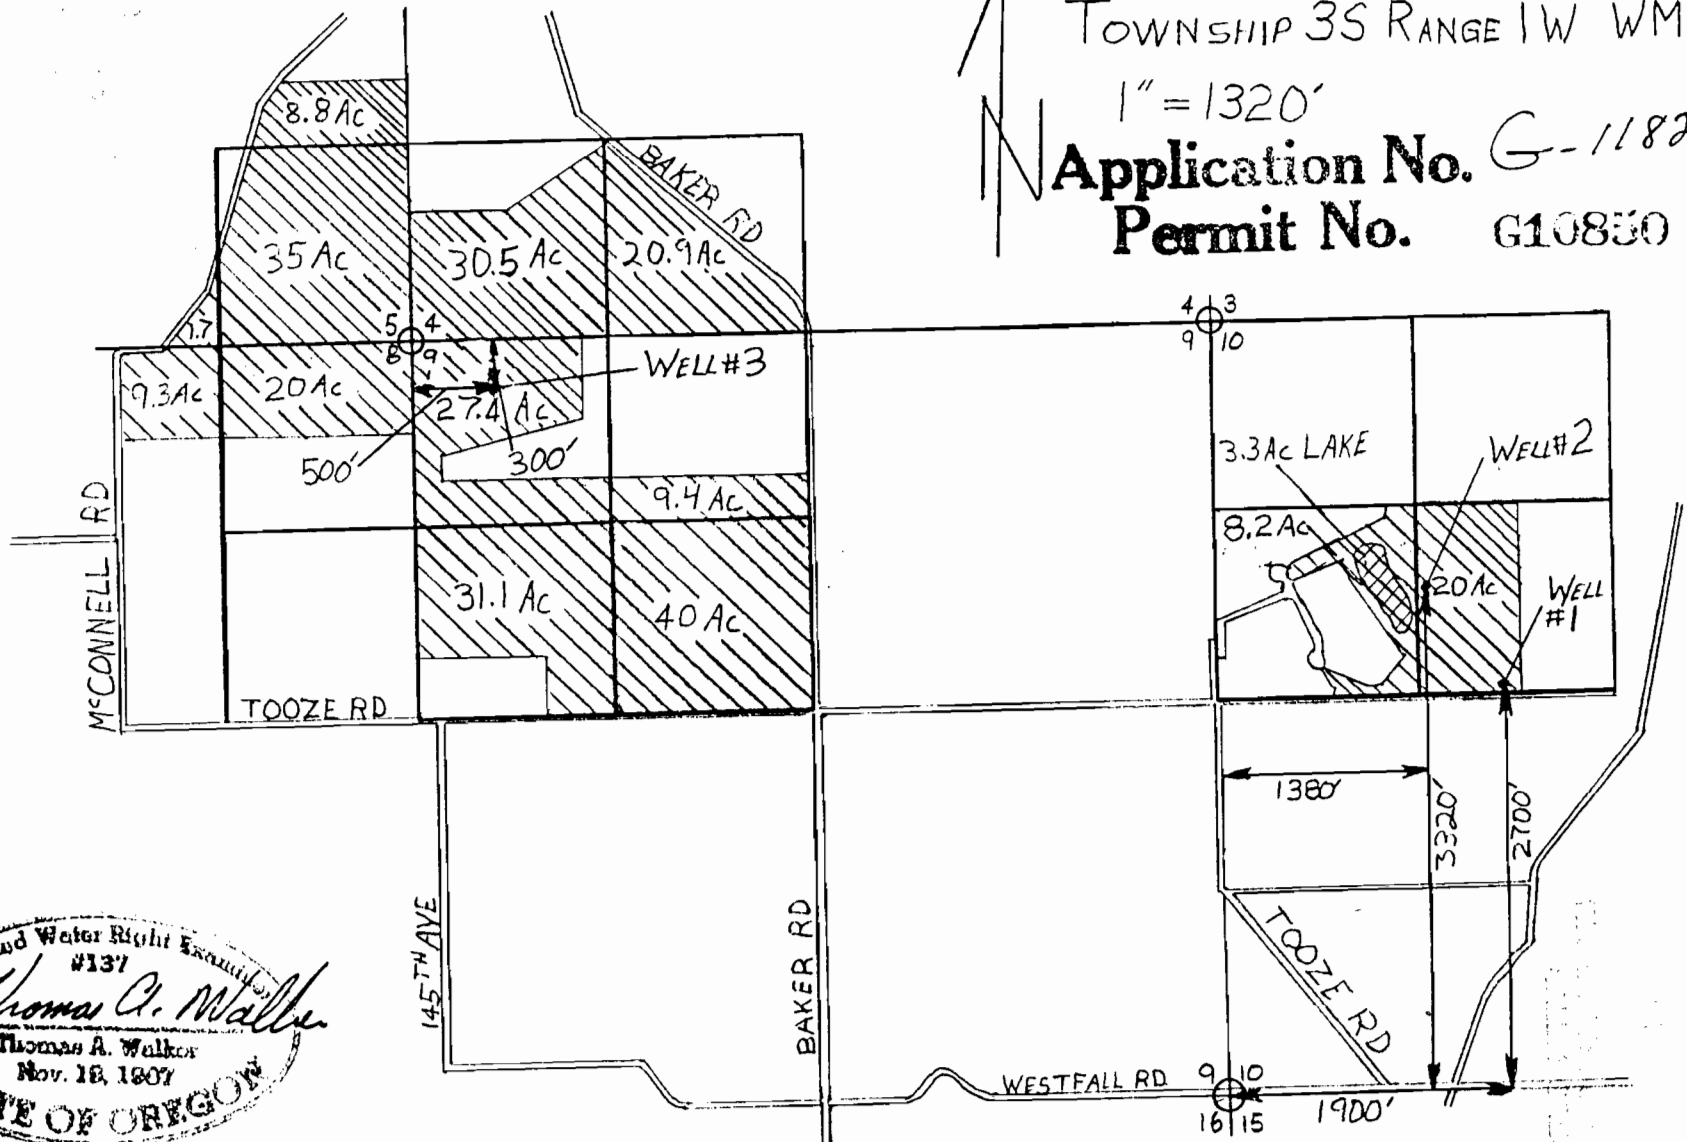

HALVORSON MASON
GROUND WATER APPROPRIATION APPLICATION
JUNE 24, 1988 JOB #: 4-206-01-01

WILSEY & HAM
ENGINEERING AND PLANNING SERVICES
Public Improvements • Land Development • Transportation