

Sec. 21 T.5N. R.36E.W.M.
UMATILLA COUNTY

5N 36 21

Aerial Photo No. 6P-121

1"=400'


RECEIVED

AUG 24 1987

WATER RESOURCES DEPT
SALEM, OREGON

Application No. **8-11671**
Permit No. **G10855**

See Map 5N 36

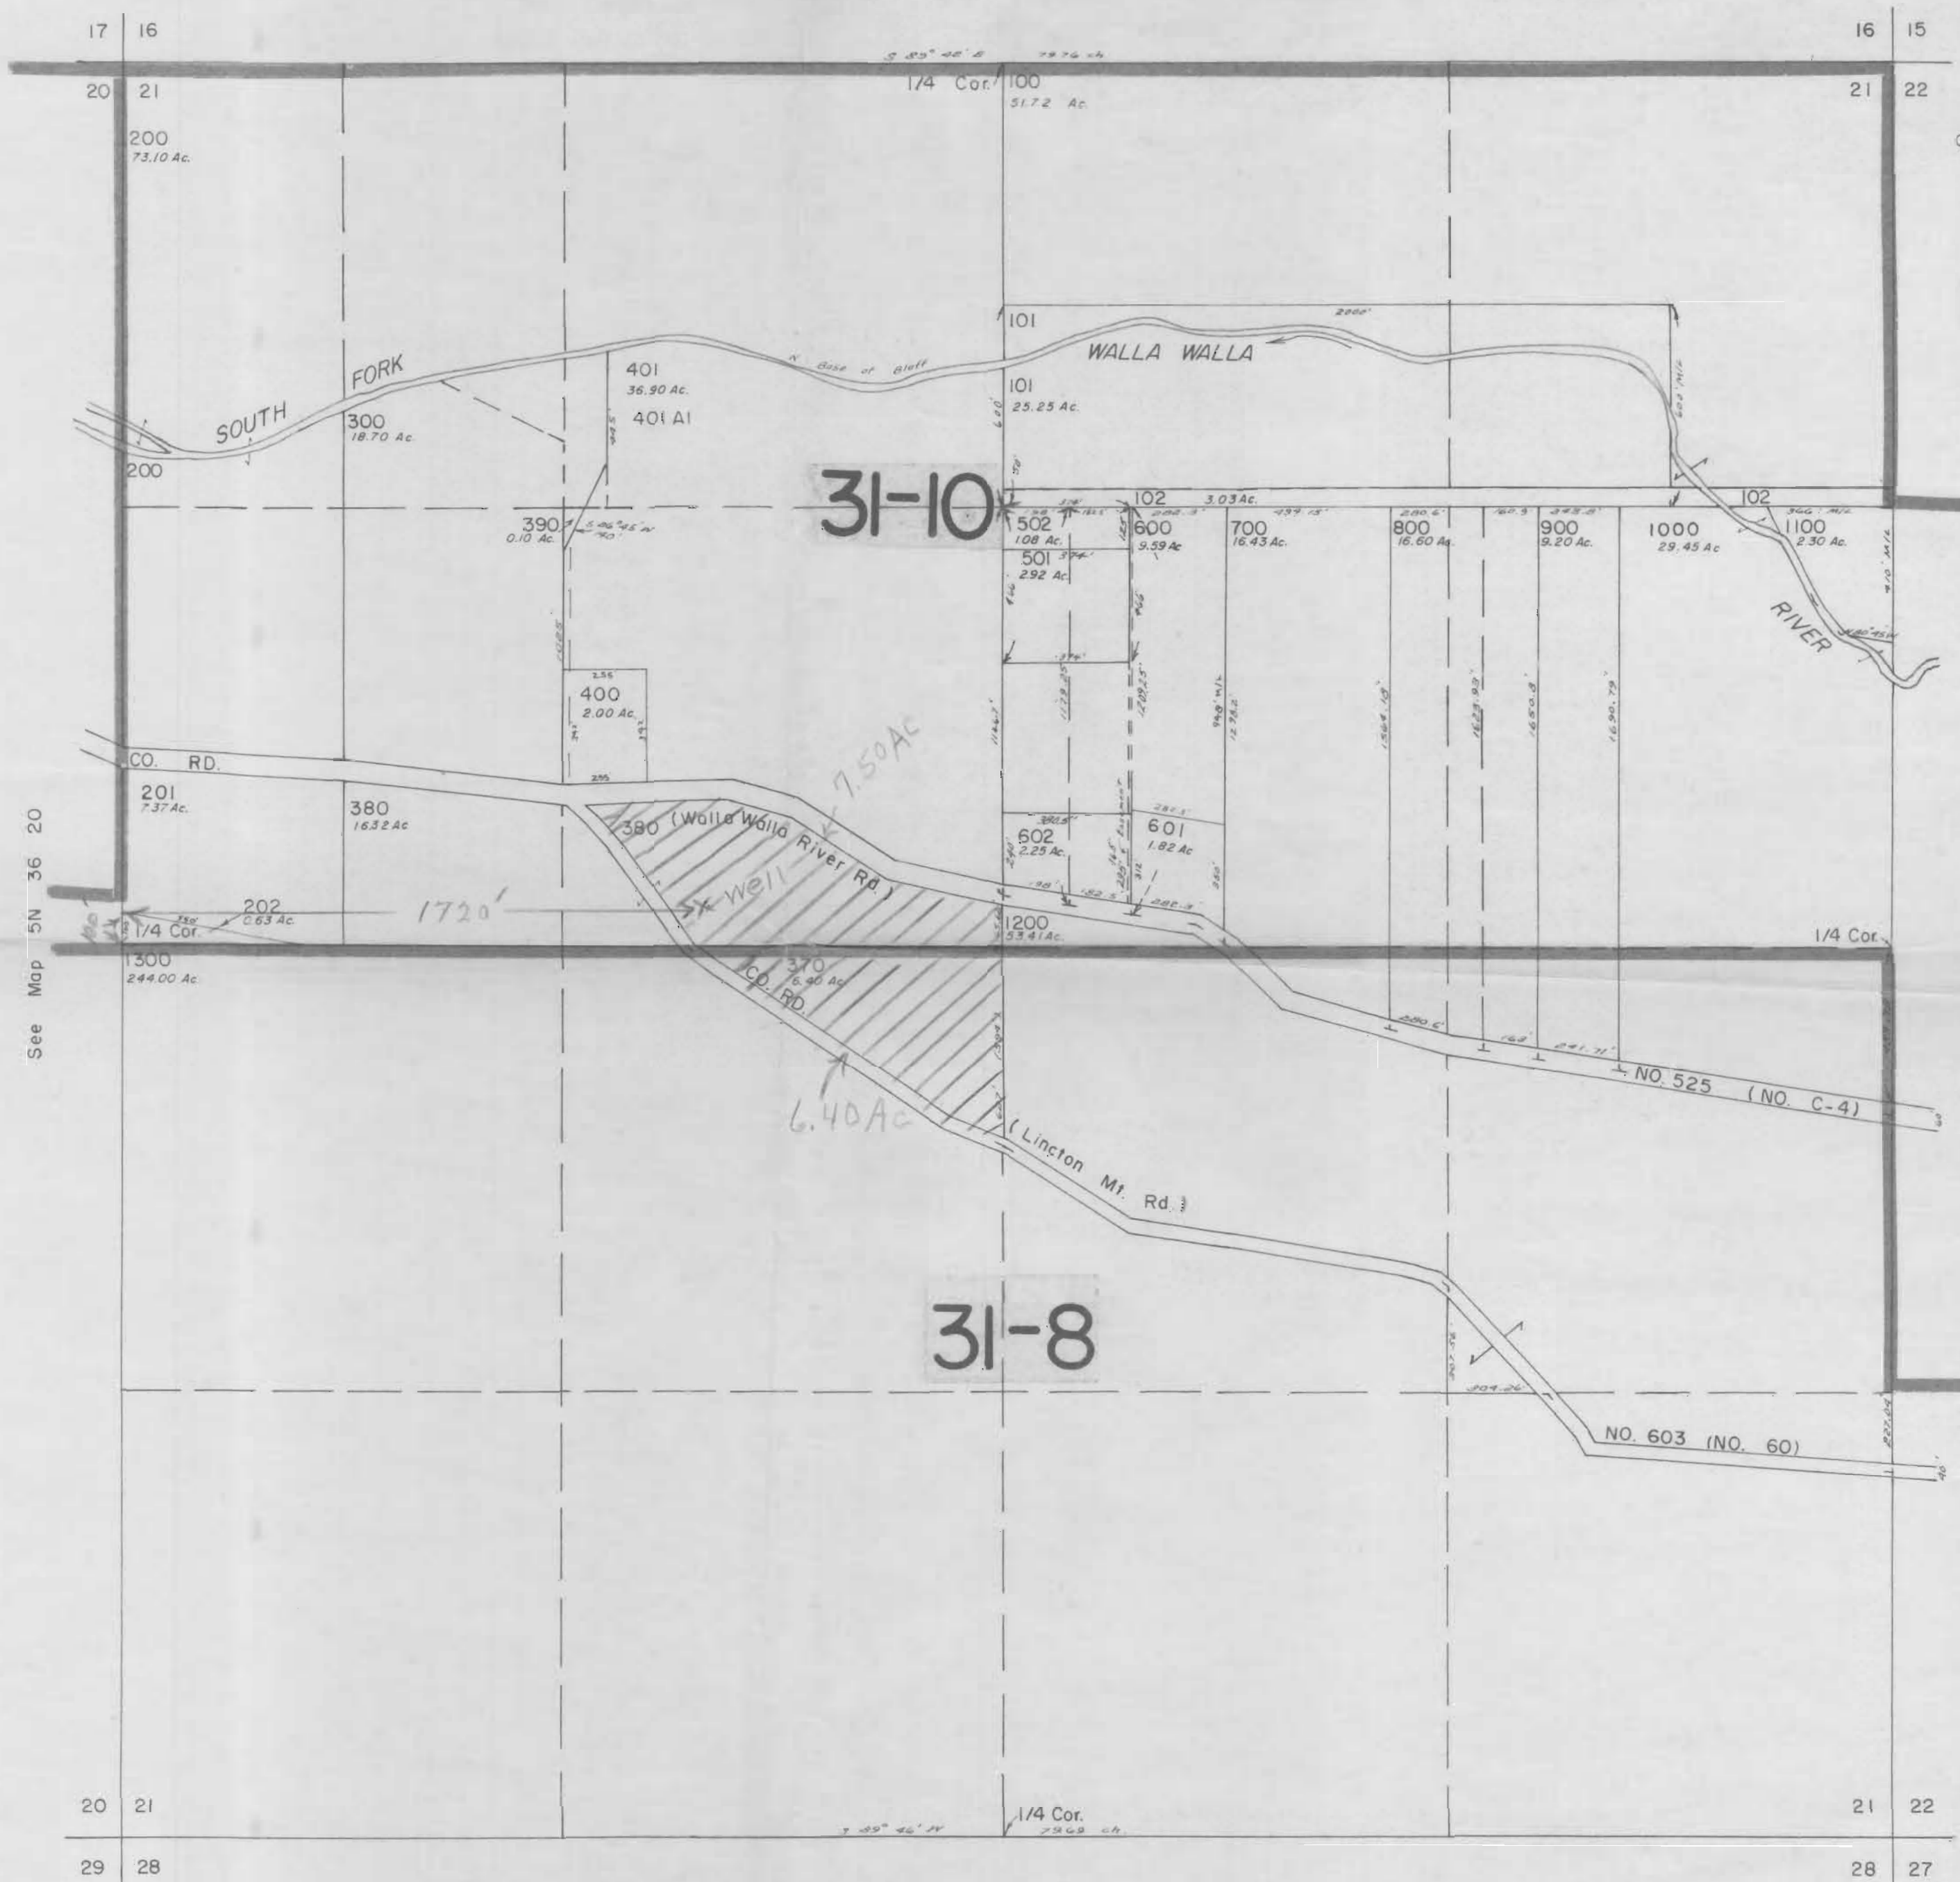

CANCELLED
TL 500

See Map 5N 36 20

See Map 5N 36 22

See Map 5N 36

5N 36 21