


FINAL PROOF SURVEY

UNDER

APPLICATION No. G-11813 PERMIT No. G-10874

IN THE NAME OF:

Dean N. and Dawn M. Baxter
1937 Washington St.
Baker City, OR 97814

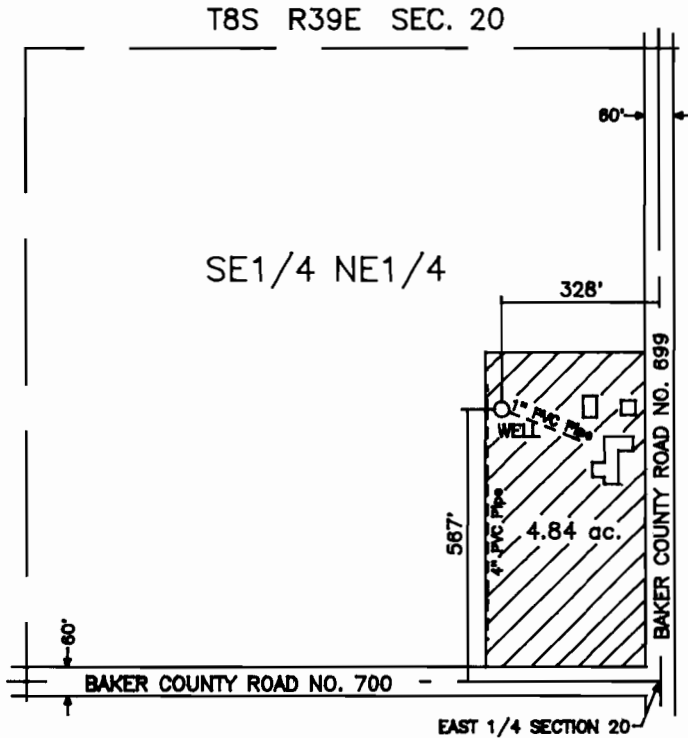


Surveyed September 28, 1993

Pipelines -----

This map is for the purpose of identifying the location of the water right only and has no intent to provide dimensions or location of property ownership lines.



SCALE 1" = 400'

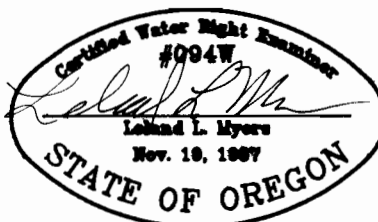

RECEIVED

SEP 30 1993

WATER RESOURCES DEPT
SALEM, OREGON