



# T.5S., R.1W., W.M.

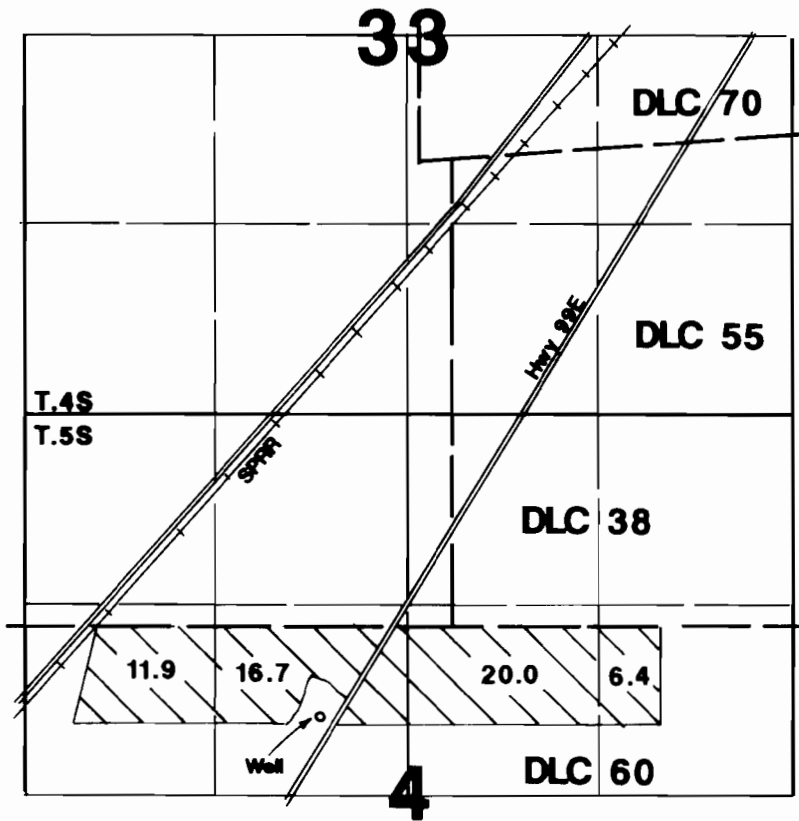

Area Irrigated

Well located 890'W & 595'S from SW corner DLC 38.

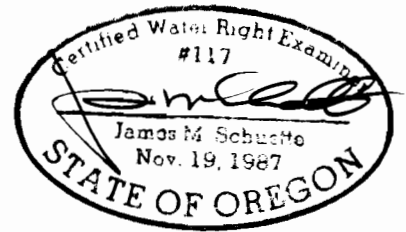

## Final Proof Survey

Application #: G-11781 Permit #: G-10882

In Name Of

### Joe E. Bronec

Surveyed on September 10, 1993 by JM Schuette

THIS MAP WAS PREPARED FOR THE PURPOSE OF IDENTIFYING THE LOCATION OF A WATER RIGHT ONLY AND IS NOT INTENDED TO PROVIDE LEGAL DIMENSIONS OR LOCATION OF PROPERTY OWNERSHIP LINES.