


Application No. G-11505
Permit No. G10897

RECEIVED

APR 10 1986

T.15S. R.42E. W.M. WATER RESOURCES DEPT
GALEN, OREGON

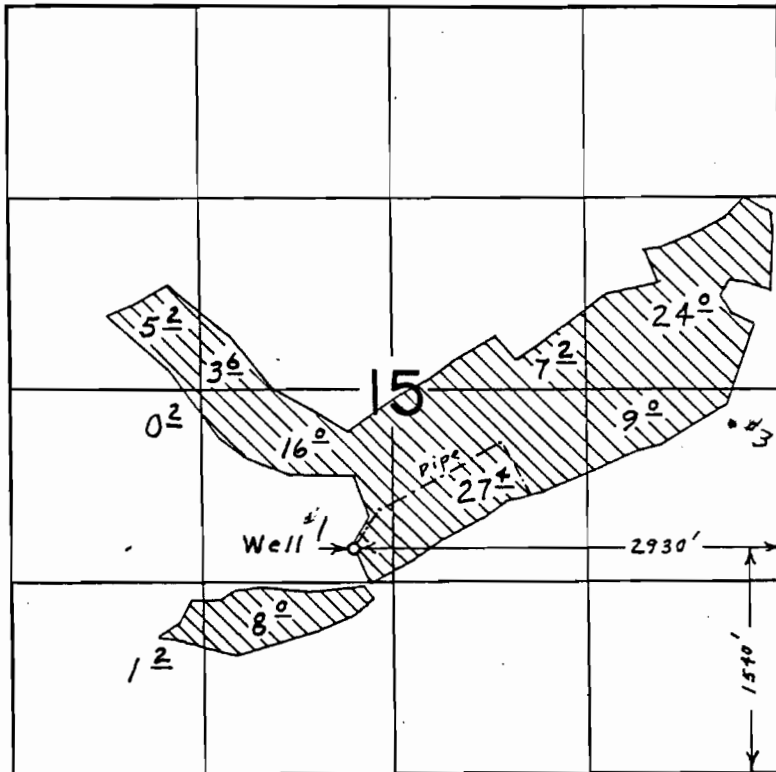

FINAL PROOF SURVEY
UNDER

Application No. G-4784 Permit No. G-4506
IN NAME OF

Keith L. McDaniel

Surveyed May 3, 1976, by L. E. Gould.