




T. 1 S., R. 32 E., W.M.

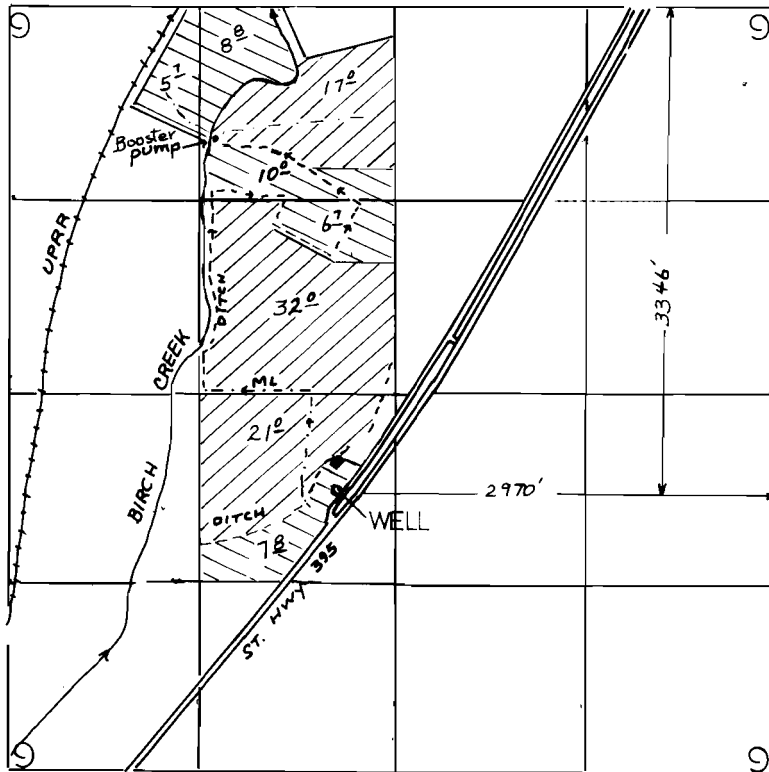

1" = 1320'

-  PRIMARY
-  SUPPLEMENTAL

FINAL PROOF SURVEY

UNDER

Application No. G-35 Permit No. G-10951
IN NAME OF

WILLIAM WEINKE

Surveyed 7-16, 1993, by J. MILLER