


T. 18 S., R. 10 E., W.M.

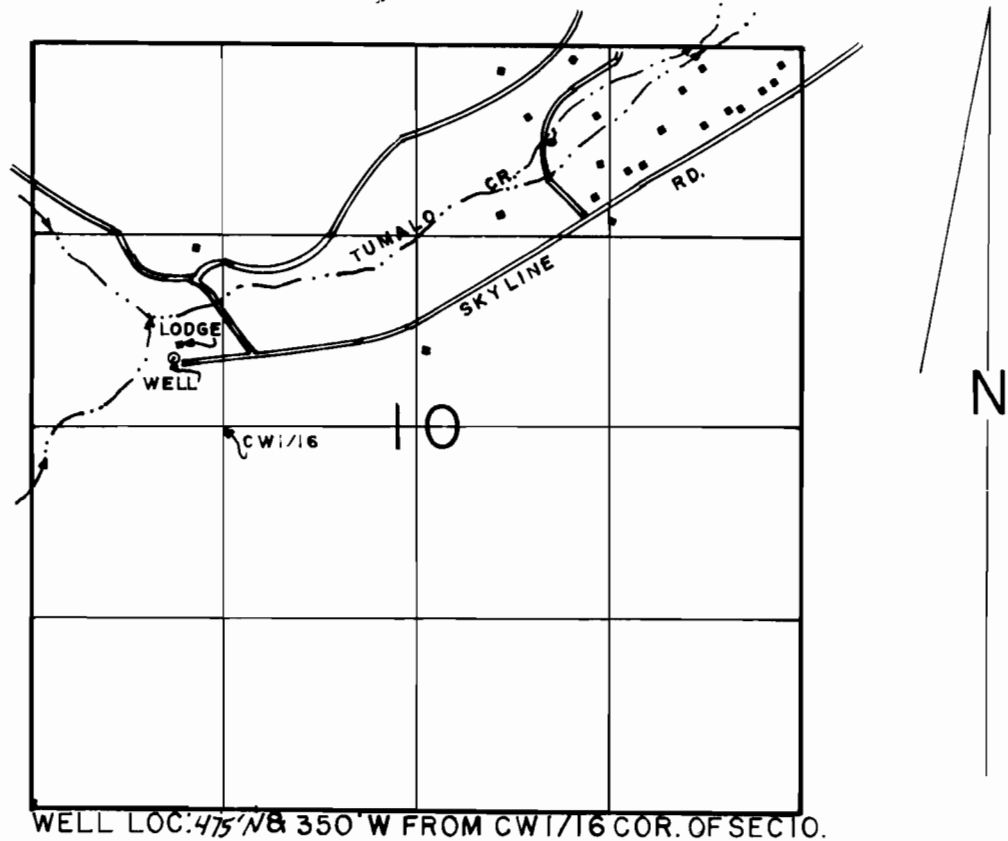

SCALE: 1" = 1320'

FINAL PROOF SURVEY

UNDER

Application No. G-11666 Permit No. G-10954
IN NAME OF

U.S. DESCHUTES NATIONAL FOREST

Surveyed MARCH 4, 1994, by R.M.SUTTERFIELD