

T.4N.,R. 25 & 26E.,W.M.

MORROW COUNTY
SCALE 1" = 1320'


WATER RIGHTS PROOF MAP
IN NAME OF
Port of Morrow

- Industrial Areas - Permits G-10975 & G-7158
- Land Application Areas - Permits G-10975 & G-7158

THIS MAP IS FOR THE PURPOSE OF IDENTIFYING THE LOCATION OF WATER RIGHTS ONLY AND IS NOT INTENDED TO PROVIDE THE LEGAL DIMENSIONS OR LOCATIONS OF PROPERTY OWNERSHIP LINES.

Well #1 Located 130 Ft. North & 2650 Ft. East from the West 1/4 Corner of Section 10
Appl. # G-7698 & Permit # G-7158

Well #4 Located 1220 Ft. South & 1200 Ft. West from the Northeast Corner of Section 10
Appl. # G-11992 & Permit # G-10975

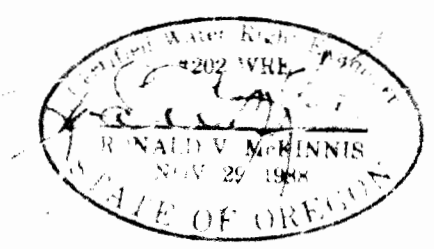

ENGINEERING - SURVEYING - WATER RIGHTS
R V McKINNIS ENGINEERING
Rt 1 Box 1122 Hermiston, Oregon 97838
503-567-2017