


- - - - - DLC BOUNDARY
 - - - - - CITY LIMITS BOUNDARY

THIS MAP WAS PREPARED FOR THE PURPOSE OF IDENTIFYING THE LOCATION OF THE WATER RIGHT ONLY AND HAS NO INTENT TO PROVIDE DIMENSIONS OR LOCATION OF PROPERTY OWNERSHIP LINES.

CITY OF GERVAIS

T.5 S. R.2 W. W.M.
 MARION COUNTY, OREGON

Cascade Pacific Engineering, Inc.
 890 Promontory Pl, SE Salem, OR 97302
 PH (503) 363-8760

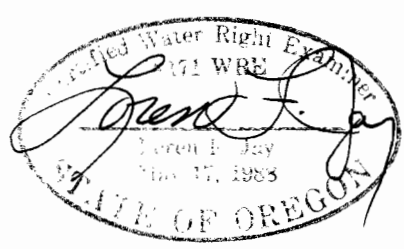

RECEIVED
 MAY 13 1991
 WATER RESOURCES DEPT
 SALEM, OREGON

FINAL PROOF SURVEY



No. G-12015
 No. G-10979