


T.4S. R.1E. W.M.

CLACKAMAS COUNTY

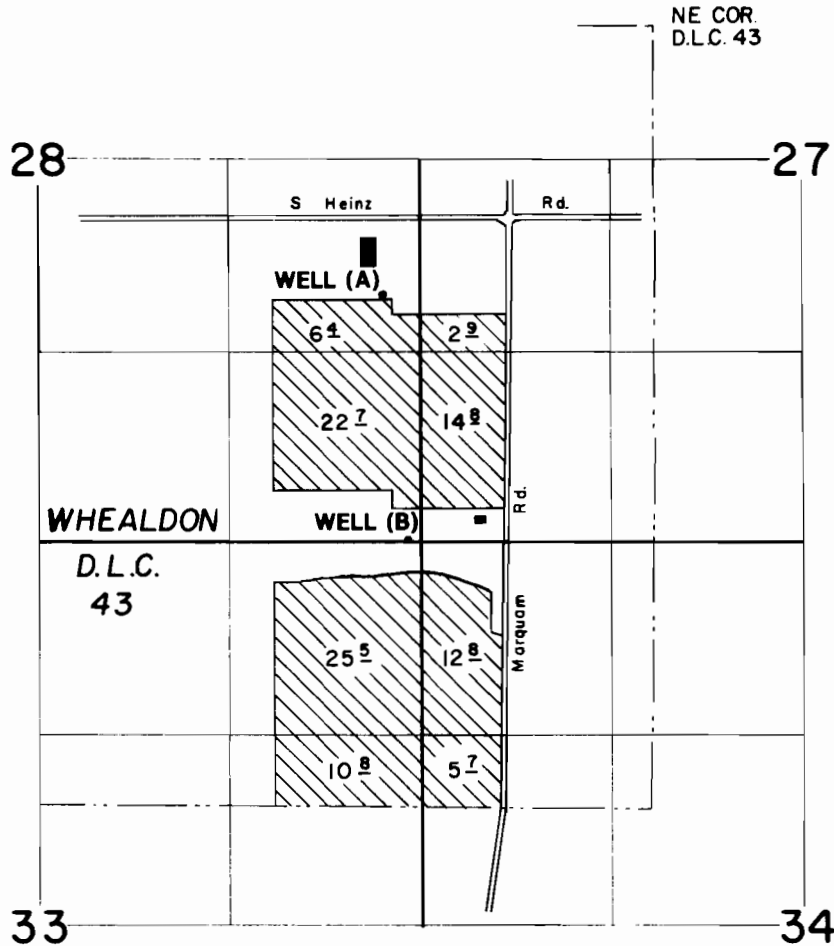

WELL (A) LOCATION : 1887' SOUTH & 1924' WEST FROM THE NE CORNER OF WHEALDON D.L.C. 43

WELL (B) LOCATION : 79' WEST & 22' NORTH FROM SE CORNER SECTION 28

FINAL PROOF SURVEY

Application No G-2980 Permit No G-11946 G-2776 G-10989 Transfer No T-6262 WELL (A) BOTH WELLS (A & B)

YULE TREE FARMS

SEPTEMBER 13, 1993

SCALE 1" = 1320'

NOTE: This map is for the purpose of identifying the location of water rights and has no intent to dimension or locate property ownership lines.

