


SECTION 29, T. 15., R. 2 W., W.M.
WASHINGTON COUNTY OREGON

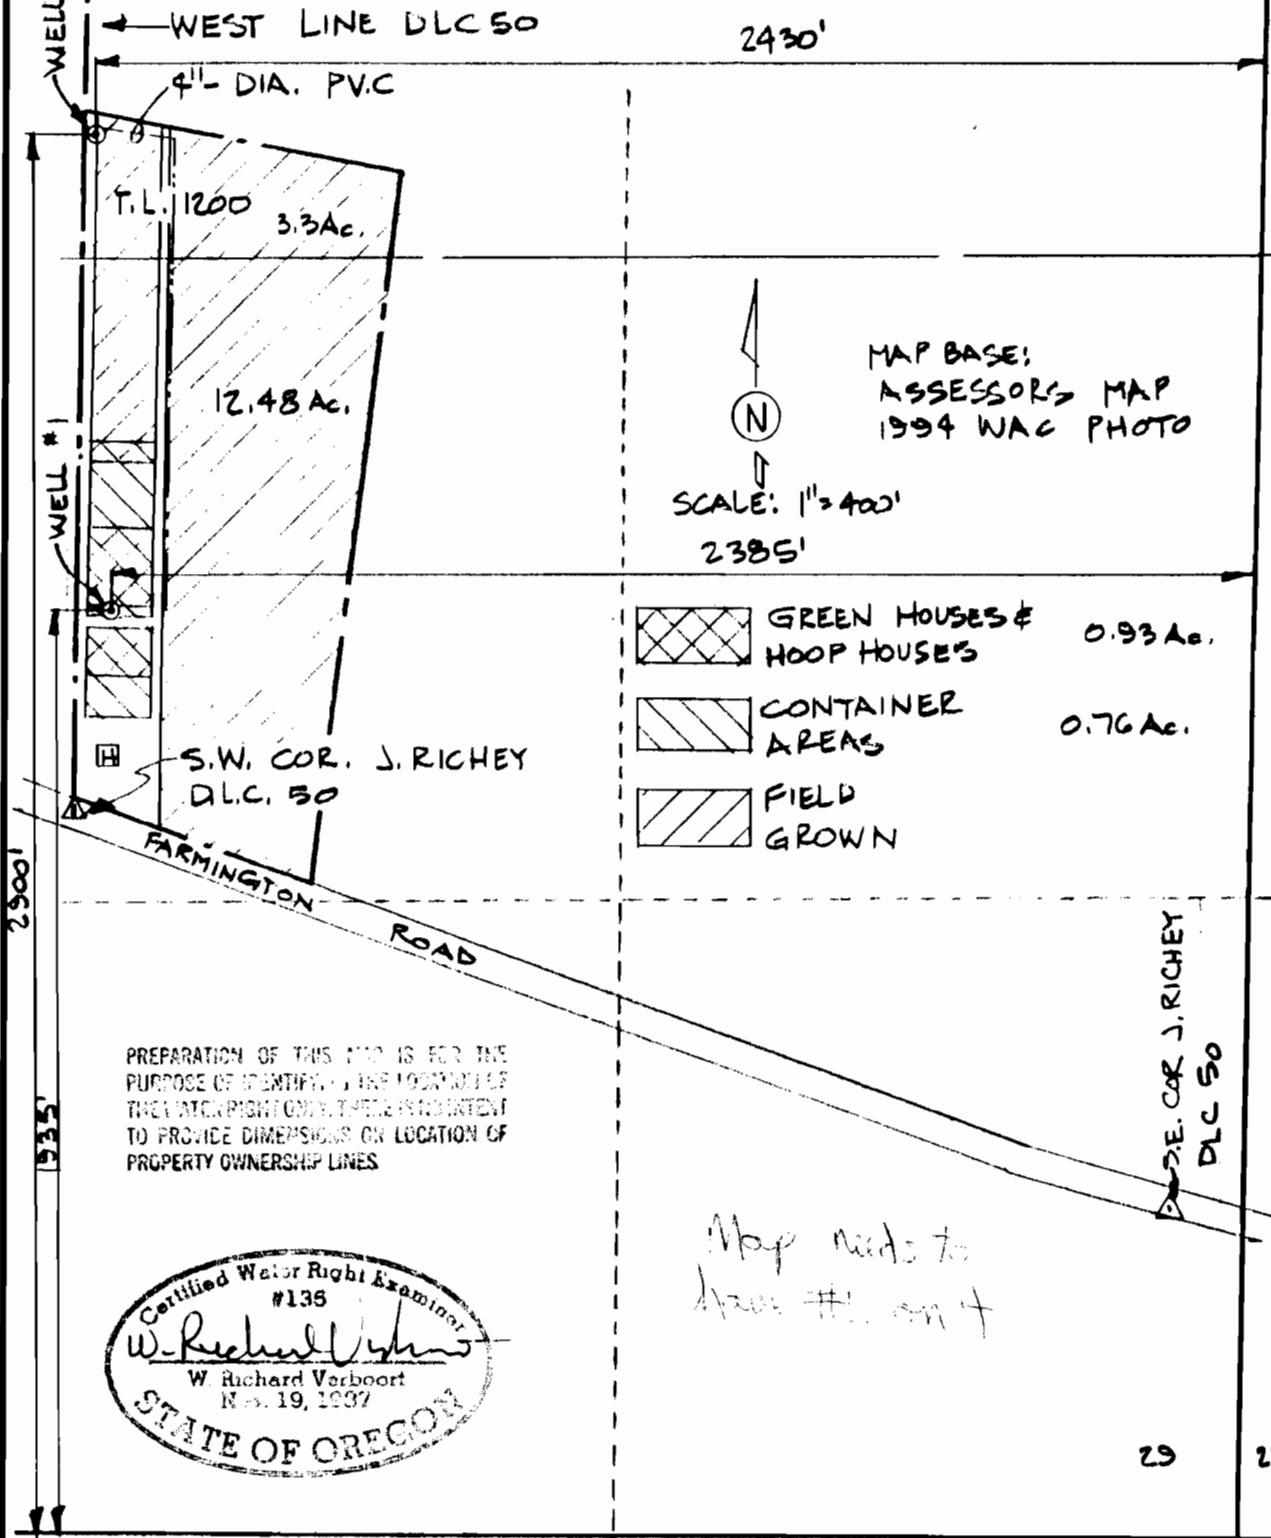

PREPARATION OF THIS MAP IS FOR THE PURPOSE OF IDENTIFYING THE LOCATION OF THE WATER RIGHT ONLY. THERE IS NO INTENT TO PROVIDE DIMENSIONS OR LOCATION OF PROPERTY OWNERSHIP LINES.

Map needs to show #1 on it



FINAL PROOF SURVEY

SURVEYED 3-7-95

VERBOORT ENGINEERING
AGRICULTURE · CIVIL · WATER RESOURCES
HILLSBORO, OREGON

by date
designed WRV 3-95
drawn JER 3-95
checked WRV 3-95
drawing no. 95-A-03
sheet no. 1/1

OREGON ORNAMENTALS
27375 S.W. FARMINGTON ROAD
HILLSBORO, OR 97123