



T.4S., R.1W., W.M.

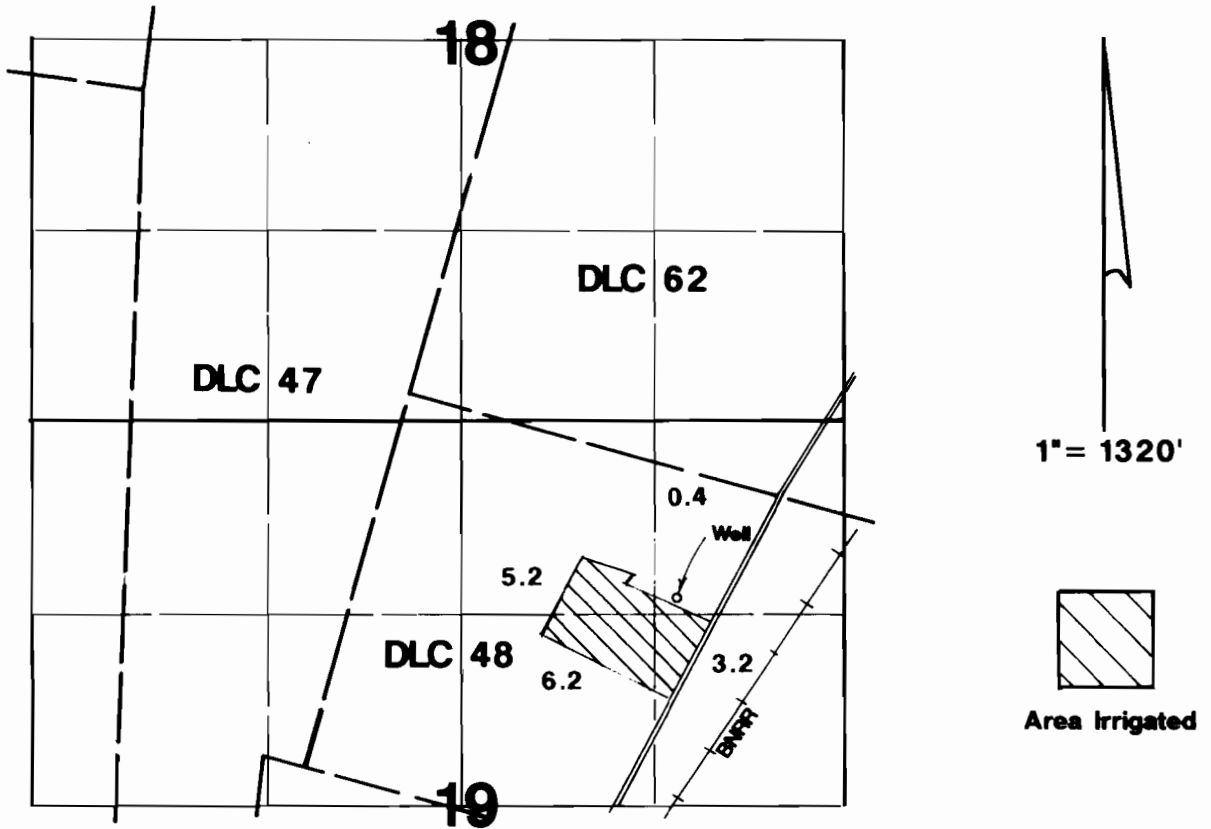

Well located 1400'S & 1850'E from NW corner DLC 48.

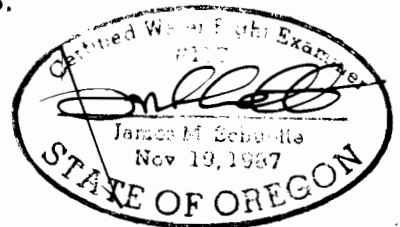

Final Proof Survey

Application #: G-11861 Permit #: G-10998

In Name Of

Erwin M. Nyquist

Surveyed on September 5, 1993 by JM Schuette

THIS MAP WAS PREPARED FOR THE PURPOSE OF IDENTIFYING THE LOCATION OF A WATER RIGHT ONLY AND IS NOT INTENDED TO PROVIDE LEGAL DIMENSIONS OR LOCATION OF PROPERTY OWNERSHIP LINES.