


T.4S., R.1E., W.M.

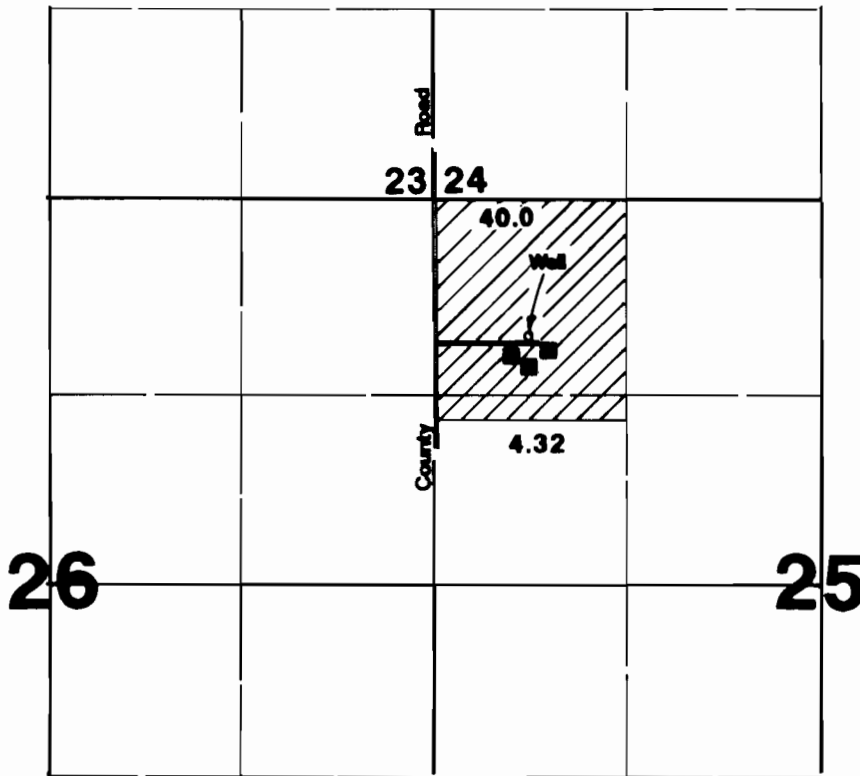

Well located 1000'S & 630'E from NW corner Section 25.

RECEIVED
AUG 28 1994
FOR RESOLUTION

Final Proof Survey

Application #: G-11898 Permit #: G-11007

In Name Of

Charles R. Morgan

Surveyed on August 25, 1994 by JM Schuetz

THIS MAP WAS PREPARED FOR THE PURPOSE OF IDENTIFYING THE LOCATION OF A WATER RIGHT ONLY AND IS NOT INTENDED TO PROVIDE LEGAL DIMENSIONS OR LOCATION OF PROPERTY OWNERSHIP LINES.

