


T. 4 N., R. 29 E., W.M.

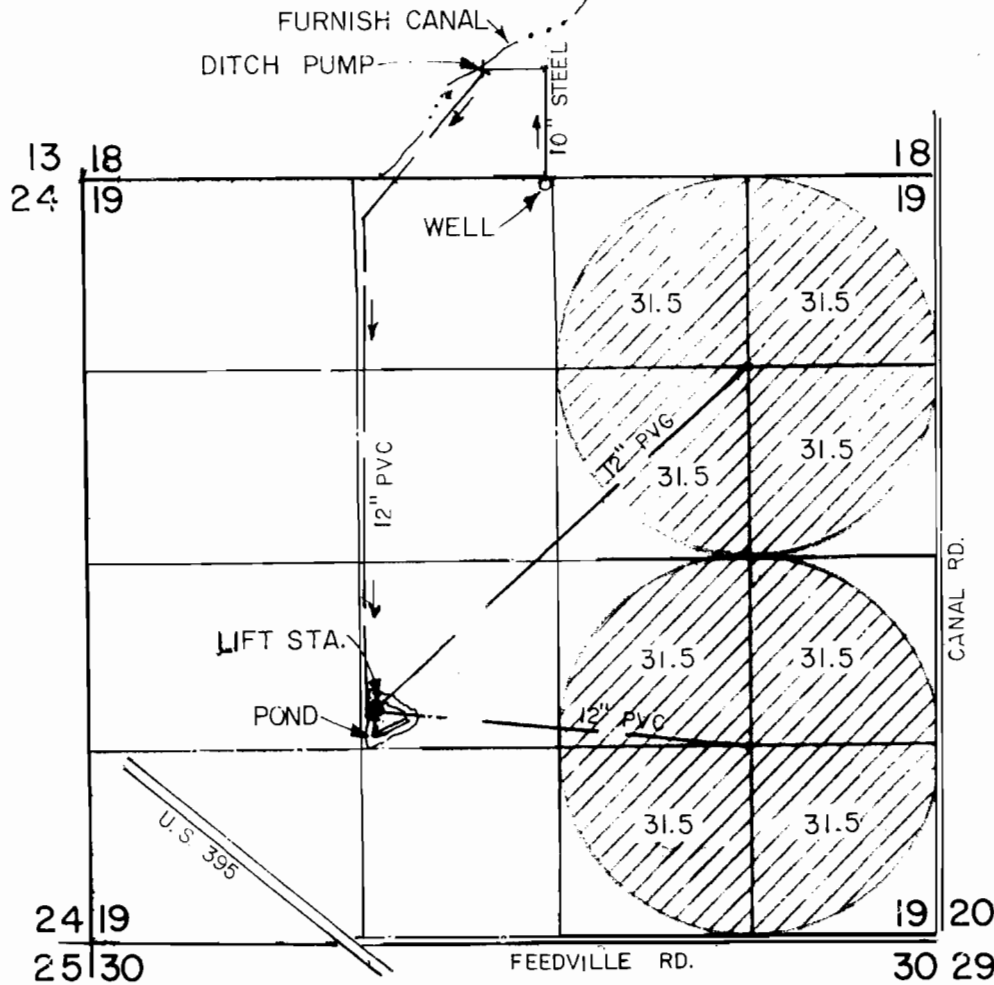

SCALE 1" = 1320'

WELL LOCATED 50'S & 40'W  
FROM N 1/4 CORNER

**FINAL PROOF SURVEY**  
UNDER

Application No. G-12012

Permit No. G-11017

IN NAME OF

**WINDBLOWN RANCH**

THIS MAP IS FOR THE PURPOSE  
OF IDENTIFYING THE LOCATION  
OF WATER RIGHTS ONLY AND IS  
NOT INTENDED TO PROVIDE  
LEGAL DIMENSIONS OR LOCATIONS  
OF PROPERTY OWNERSHIP LINES.

