


T. 39 S. R. 13 E. W. M.

RECEIVED

NOV 15 1977

WATER RESOURCES DEPT
SALEM, OREGON

RECEIVED
APR 4 1978
WATER RESOURCES DEPT.
SALEM, OREGON

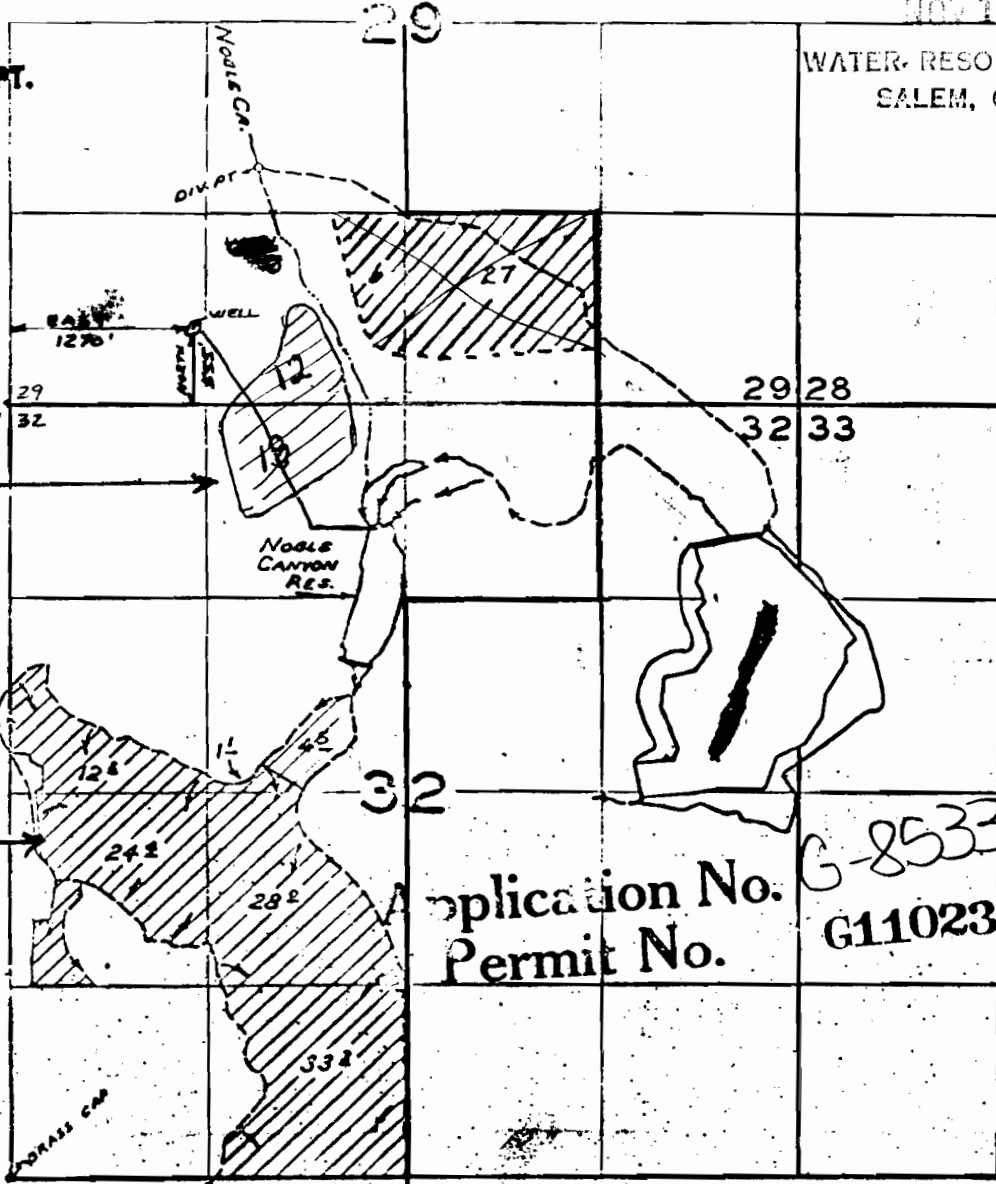

Application No.
Permit No.

G-8533
G11023