

RECEIVED

OCT 18 1995

WATER RESOURCES DEPT.
SALEM, OREGON

NE 1/4, SW 1/4

NW 1/4, SE 1/4

18.7 ACRES

SE 1/4, SW 1/4

SW 1/4, SE 1/4

NEW

100'

PLEASANT VIEW RD.

1160'

1/4 28
33

NE 1/4, SW 1/4

NW 1/4, NW 1/4

KRUMBEIN ENGINEERING LTD.
ENGINEERS - SURVEYORS - PLANNERS
361 S.E. Second Pendleton, Oregon

Scale
1" = 400'
Date
15 NOV 84

Drn. By
DHK
Ckd. By

Drng. No.
8414A
Job No.
9430


Revision 1
Revision 2

FINAL PROOF SURVEY

PHILLIPS G-11030

SE 1/4, SW 1/4, SECTION 28

T.6 N., R.35 E. W.M.

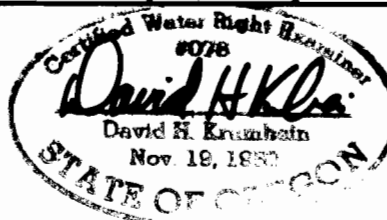

RENEWS 6/30/85