

FINAL PROOF SURVEY

NEW WELL LOCATION
(WELL NO. 7)

27

26

25

30



CITY OF
Dundee

SERVICE
BOUNDARY

35

36

31

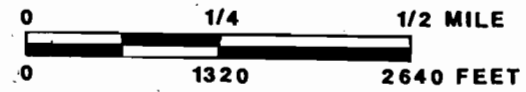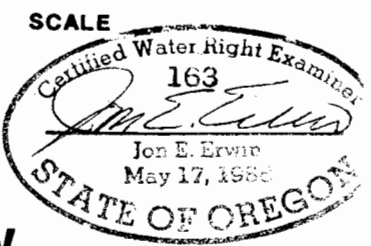

T. 3 S.

R. 2 W.

