


T. 8 S. R. 39 E. W.M.

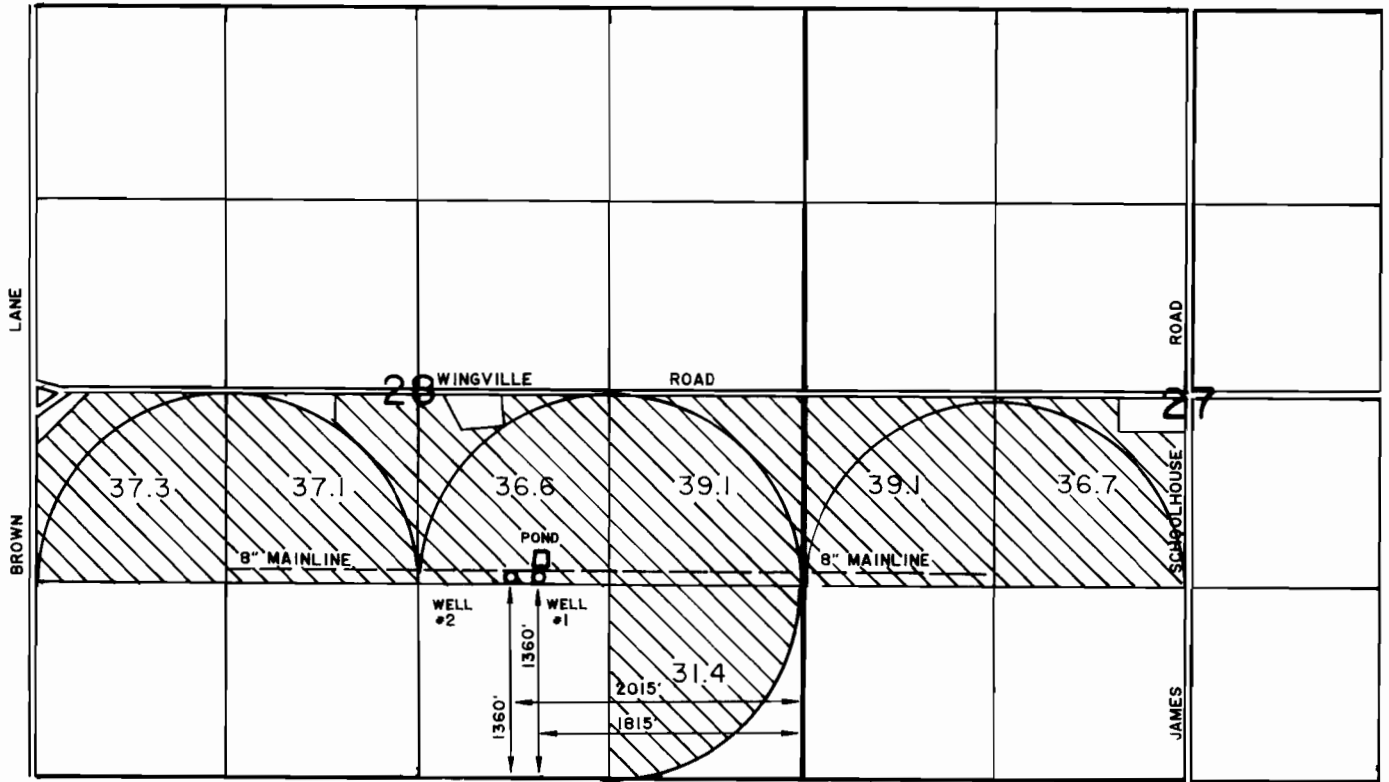

SCALE 1" = 1320'

The purpose of this map is for identifying the location of the water right only and is not intended to provide legal dimensions of property ownership lines.

FINAL PROOF SURVEY

UNDER

Application No. G-11736 Permit No. G-11077

IN NAME OF

DAVID L. BLATCHFORD

Surveyed October 27, 1994

