


T 16 S., R. 4 W., W.M.

Section 15

N
4
D

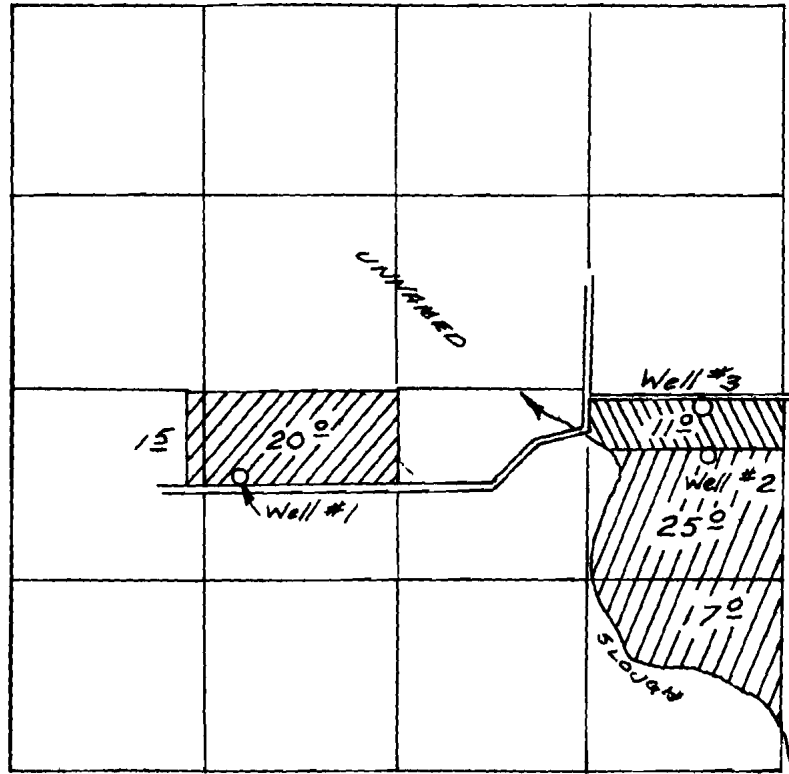

SCALE 4" = 1 MILE

Wells Located: #1 - 600 feet South and 1550 feet East from W/4 Corner Section 15; #2 - 400 feet South and 550 feet West; #3 - 50 feet South and 550 feet *

Application G-8994 Permit 611095
for

John T. Brice

* West, both from E/4 Corner, Section 15.