


SECTION 5 & 8, T.2S., R.2W., W.M.

WASHINGTON COUNTY, OREGON

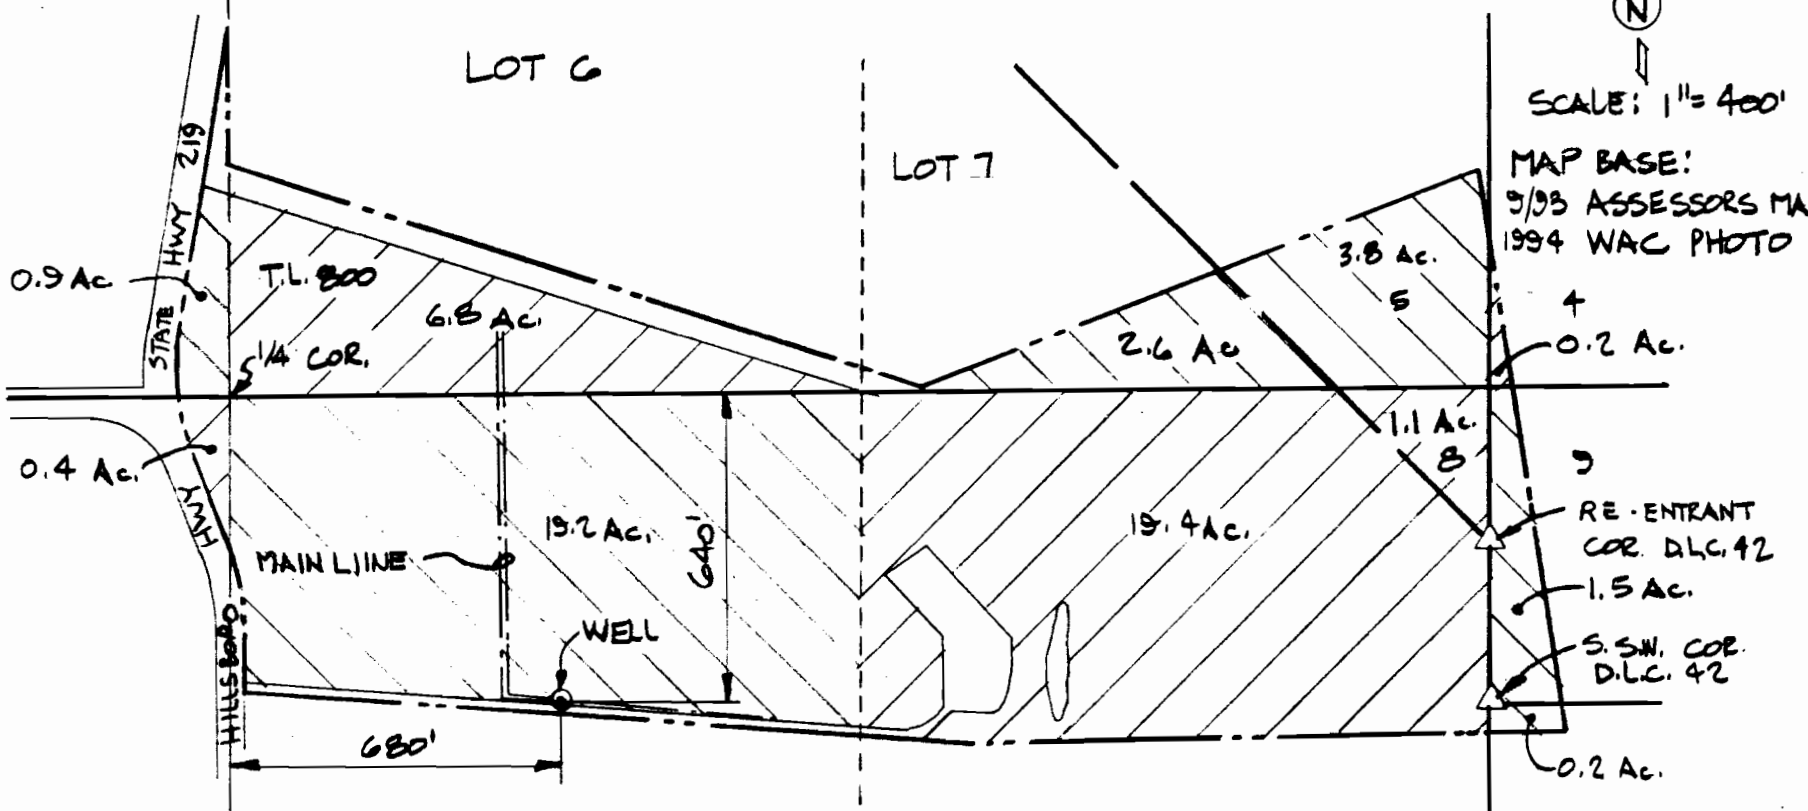


SCALE: 1" = 400'

MAP BASE:
9/93 ASSESSORS MAP
1994 WAC PHOTO

MOLLY H. & DEKE TIETZE
14210 S.W. HILLSBORO HWY
HILLSBORO, OR 97123

designed	WRY 9/95
drawn	JOE 9/95
checked	WRY 9/95
drawing no.	95-A-12
sheet no.	1/1

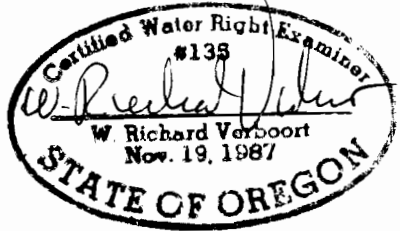

FINAL PROOF SURVEY
UNDER
APPLICATION G-12140 PERMIT G-11104
SURVEYED 9/5/95

PREPARATION OF THIS MAP IS FOR THE
PURPOSE OF IDENTIFYING THE LOCATION OF
THE WATER RIGHT ONLY THERE IS NO INTENT
TO PROVIDE DIMENSIONS OR LOCATION OF
PROPERTY OWNERSHIP LINES.

VERBOORT ENGINEERING
AGRICULTURE-CIVIL-WATER RESOURCES
HILLSBORO, OREGON