


SECTION 1 T2S R3W WM WASHINGTON COUNTY OREGON
 WATER RIGHT MAP

FOR RICHARD EGGER Application No. 8-11883
 ROUTE 2, Box 362 Permit No. G11118
 HILLSBORO, OR 97123

RECEIVED

JAN 19 1989

WATER RESOURCES DEPT.
 SALEM, OREGON

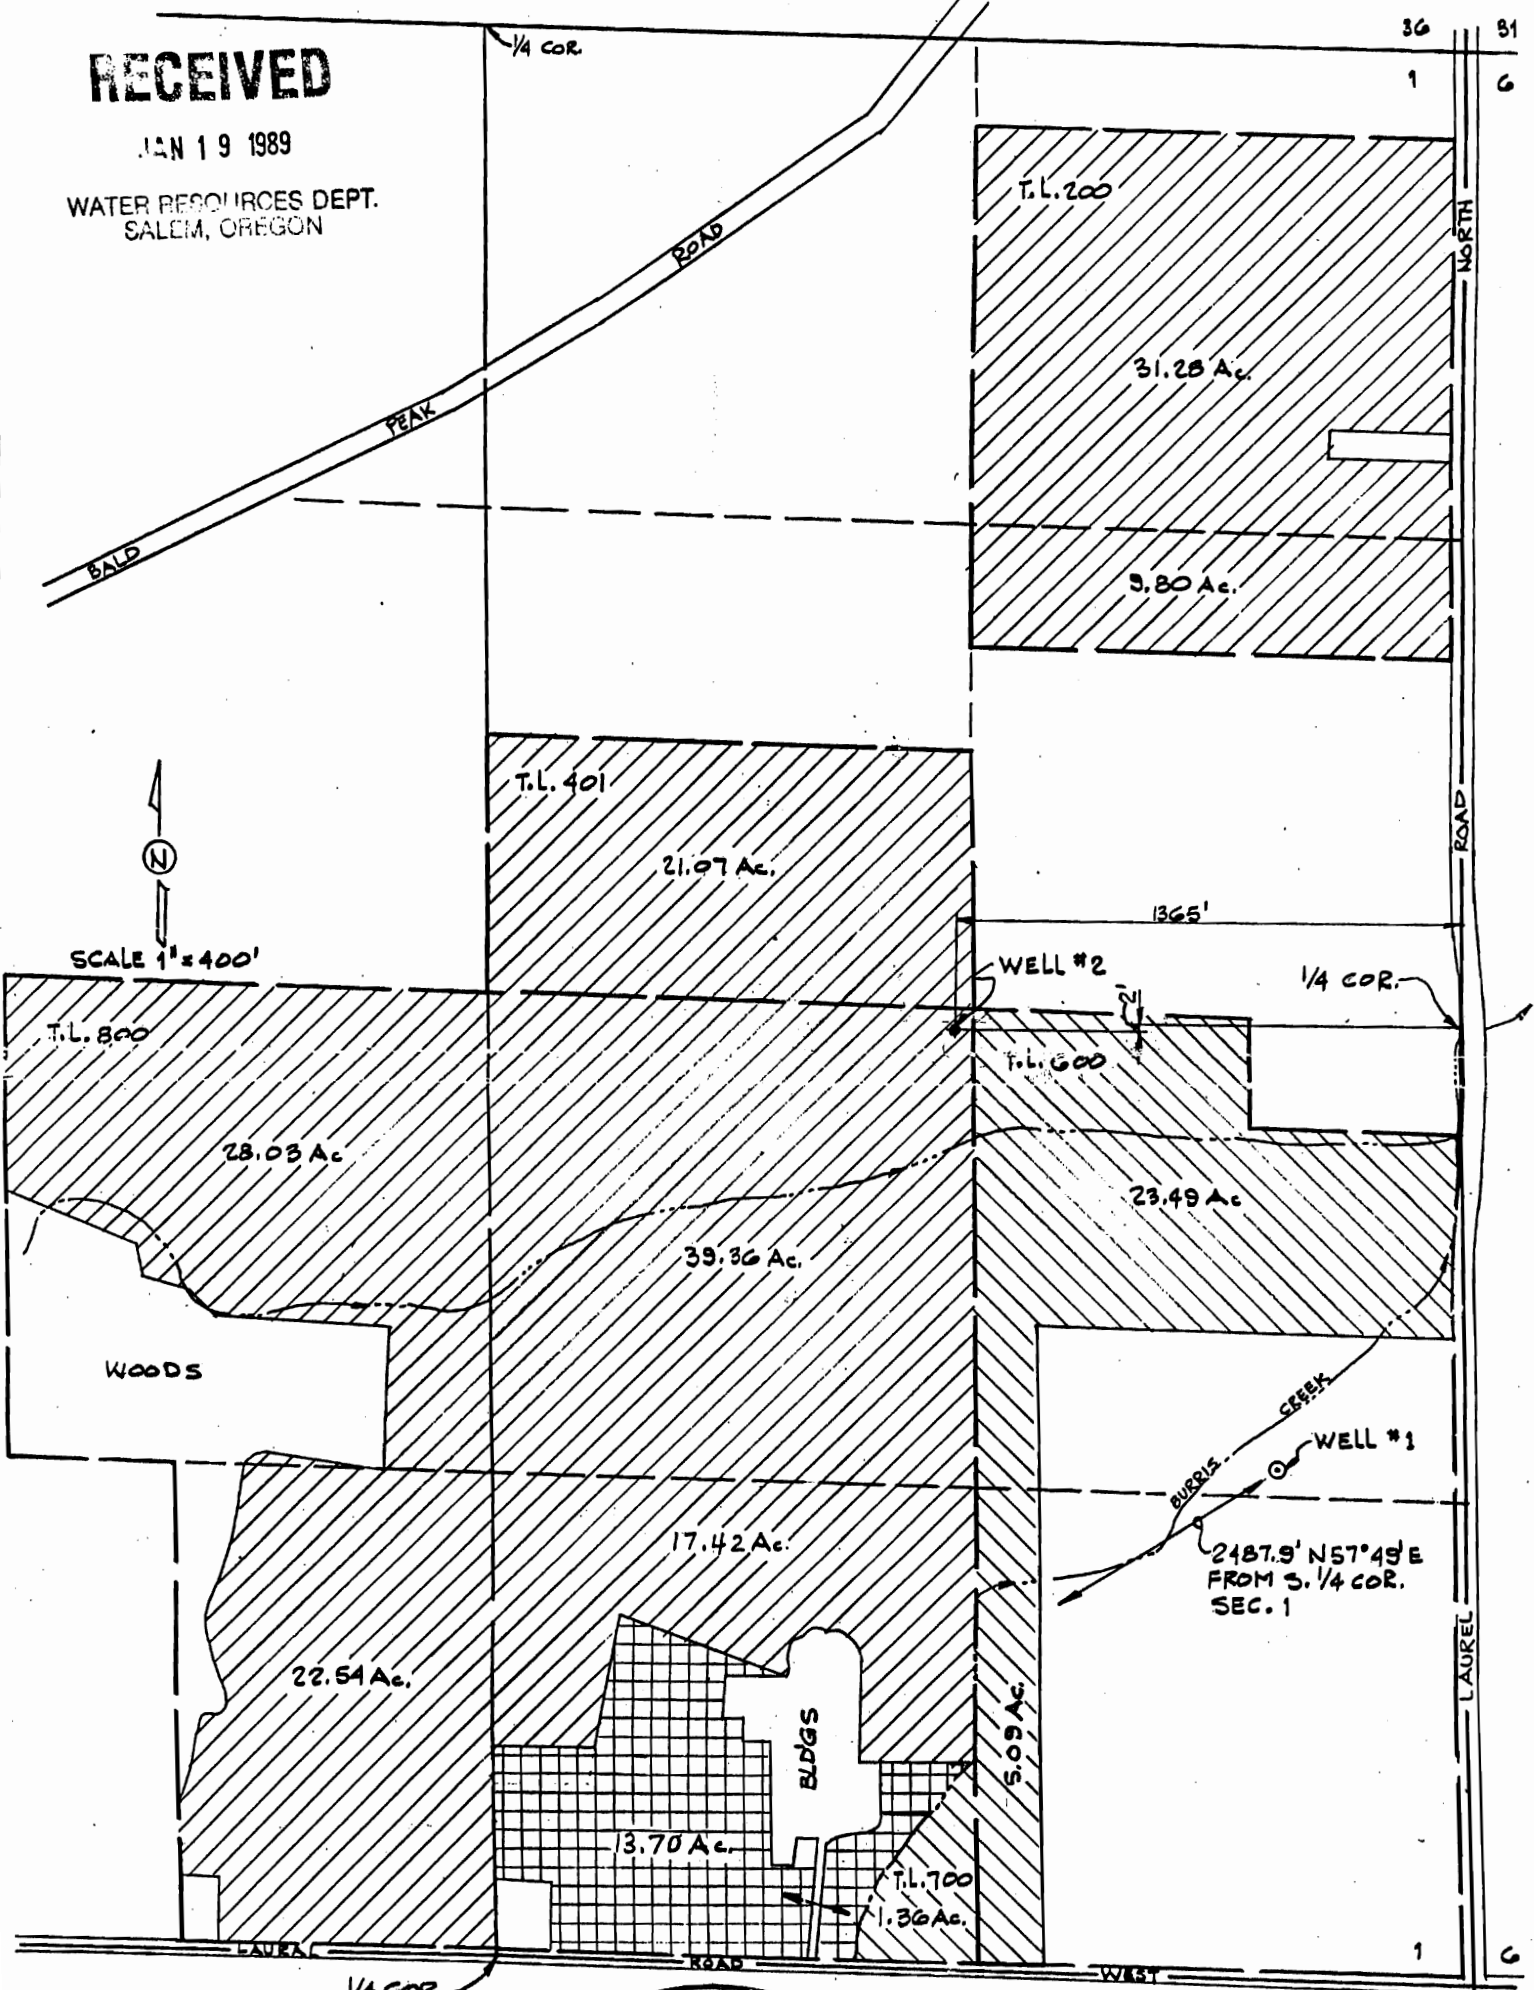

SCALE 1" = 400'

WOODS

BLDG'S

- WELL #2 NEW IRRIGATED AREA
- WELL #1 NEW IRRIGATED AREA
- FROM WELL #2 SUPPLEMENTAL TO PERMIT 18533, CERT. 20084

Certified Water Right Examiner
 #135
W. Richard Verboort
 W. Richard Verboort
 Nov. 19, 1987
 STATE OF OREGON

PREPARATION OF THIS MAP IS FOR THE PURPOSE OF IDENTIFYING THE LOCATION OF THE WATER RIGHT ONLY. THERE IS NO INTENT TO PROVIDE DIMENSIONS OR LOCATION OF PROPERTY OWNERSHIP LINES.

PREPARED BY:
 W. RICHARD VERBOORT, P.E.