



# T.8S. R.IW., W.M.

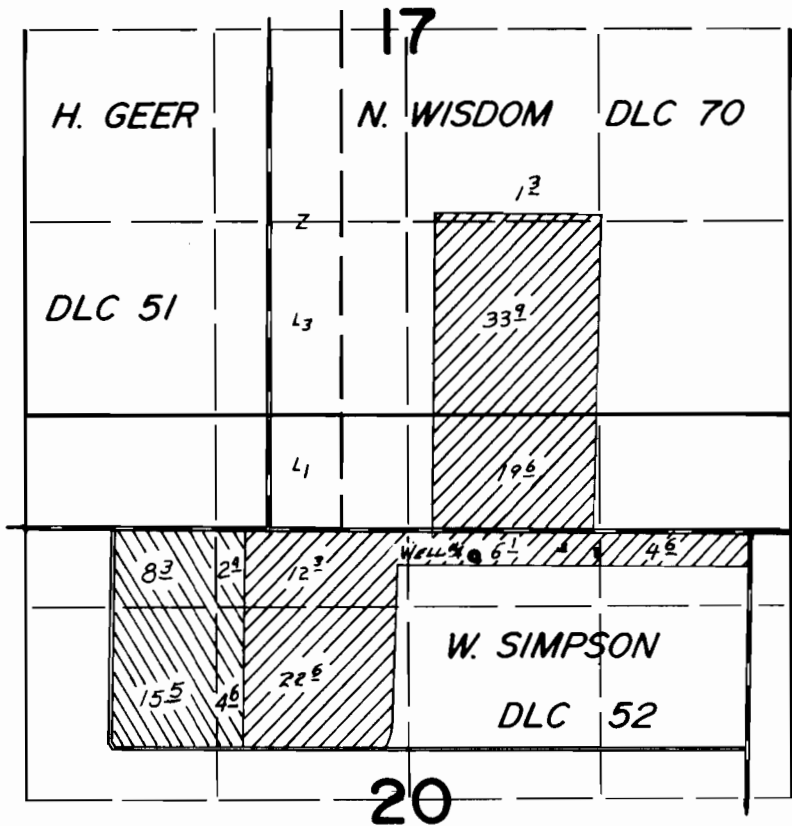

WELL Loc. 180'S. & 1400' E. FROM S.E. COR. DLC 51

 Irrigation - This appl.

THIS MAP WAS PREPARED FOR THE PURPOSE OF IDENTIFYING THE LOCATION OF A WATER RIGHT ONLY AND IS NOT INTENDED TO PROVIDE LEGAL DIMENSIONS OR LOCATION OF PROPERTY OWNERSHIP LINES.

## FINAL PROOF SURVEY

UNDER

Application No. G-12001 Permit No. G-11127

IN NAME OF

Delbert Hendricks

dba DELS FARMS, INC.

Surveyed Oct 29 1994, by

