


**FINAL PROOF SURVEY
OF A PERMIT FOR
GROUND WATER APPROPRIATION**
SITUATED IN THE S.W. 1/4 OF SECTION 20
AND THE N.W. 1/4 OF SECTION 29, T-1N,
R-1W, W.M., WASHINGTON COUNTY, OREGON

APPLICATION NO: G-12094
PERMIT NO: G-11129

SCALE: 1"=400'
DATE: 9-21-94

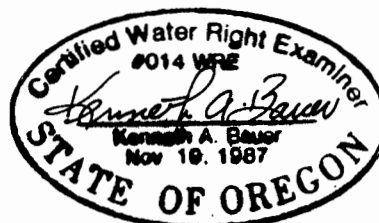

NOTE:
THIS MAP IS FOR THE PURPOSE OF IDENTIFYING THE
LOCATION OF THE WATER RIGHT ONLY AND IS NOT
INTENDED TO PROVIDE LEGAL DIMENSIONS OR LOCATIONS
OF PROPERTY OWNERSHIP LINES.

KENNETH A. BAUER
P.O. BOX 550
LAFAYETTE, OR 97127
PH: (503) 864-2056