


Township 6 South, Range I East, W.M.
Portions of Sections 4, 5, 8 & 9


11

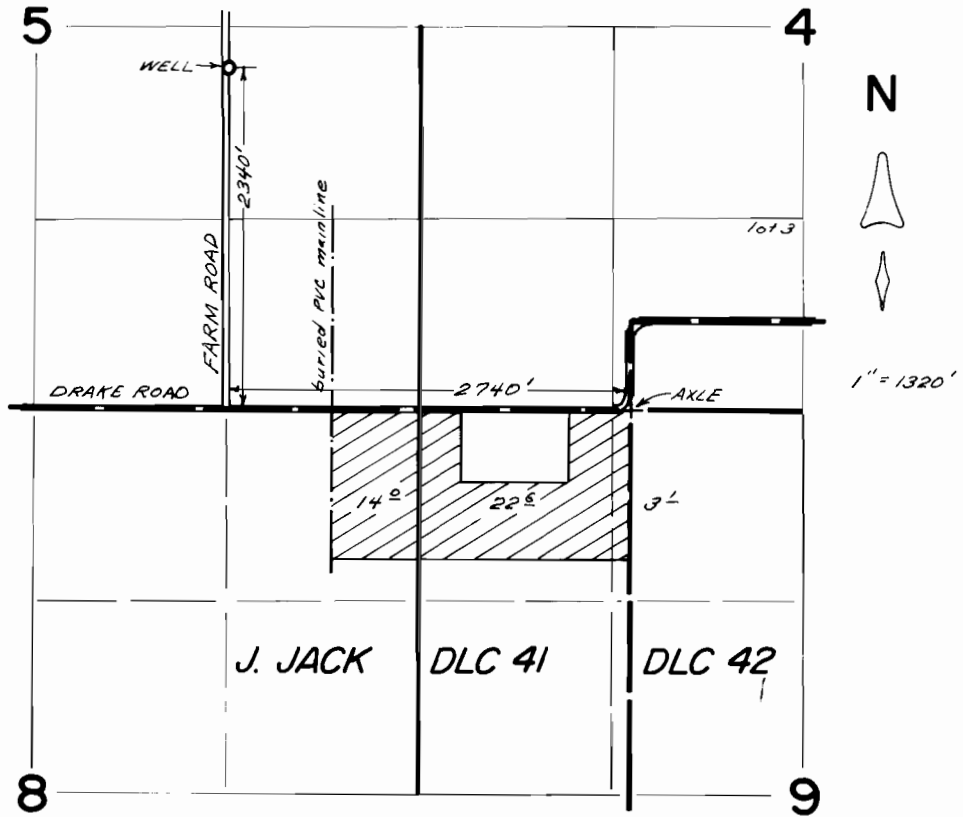

FINAL PROOF SURVEY
under
Appl. No. G-12029, Per. No. G-11131
in name of

VICTOR SCHNEIDER

October 4, 1994

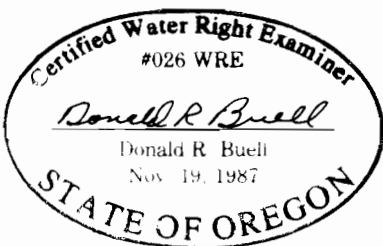

THIS MAP WAS PREPARED FOR THE PURPOSE OF IDENTIFYING THE LOCATION OF A WATER RIGHT ONLY AND IS NOT INTENDED TO PROVIDE LEGAL DIMENSIONS OR LOCATION OF PROPERTY OWNERSHIP LINES.