


T. 7 S. R. 1 W., W.M.

COX
DLC
58

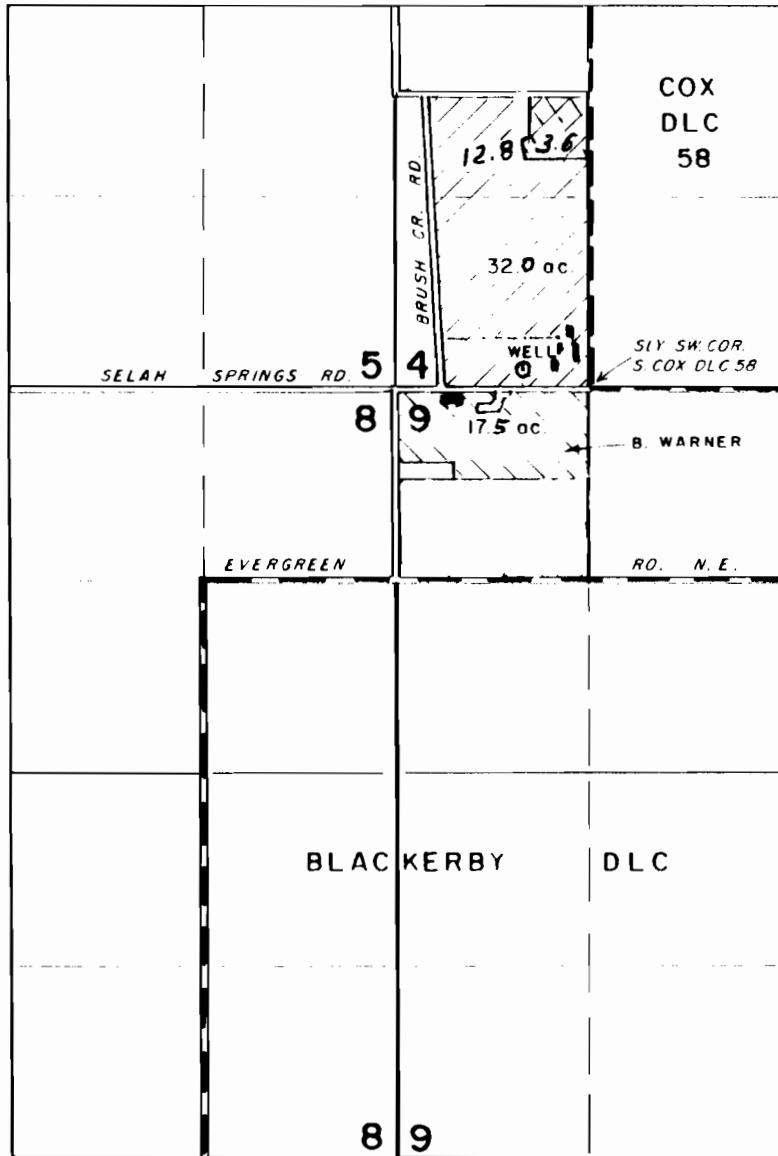

4" = 1 MILE



WELL LOC : 130' N & 465' W FROM SLY S.W. COR. S. COX DLC 58

FINAL PROOF WATER RIGHT MAP FOR HARRY KLOPFENSTEIN

SURVEYED ON JULY 16, 1990 *Sept. 12, 1994*

*1162 down rd
1990-11-15
APP. 5-1-1994
PAGE 1-1022*

THIS MAP WAS PREPARED FOR THE PURPOSE OF IDENTIFYING THE LOCATION OF A WATER RIGHT ONLY AND IS NOT INTENDED TO PROVIDE LEGAL DIMENSIONS OR LOCATION OF PROPERTY OWNERSHIP LINES.

BY :

