


T.2S., R.3 & 4E., W.M.

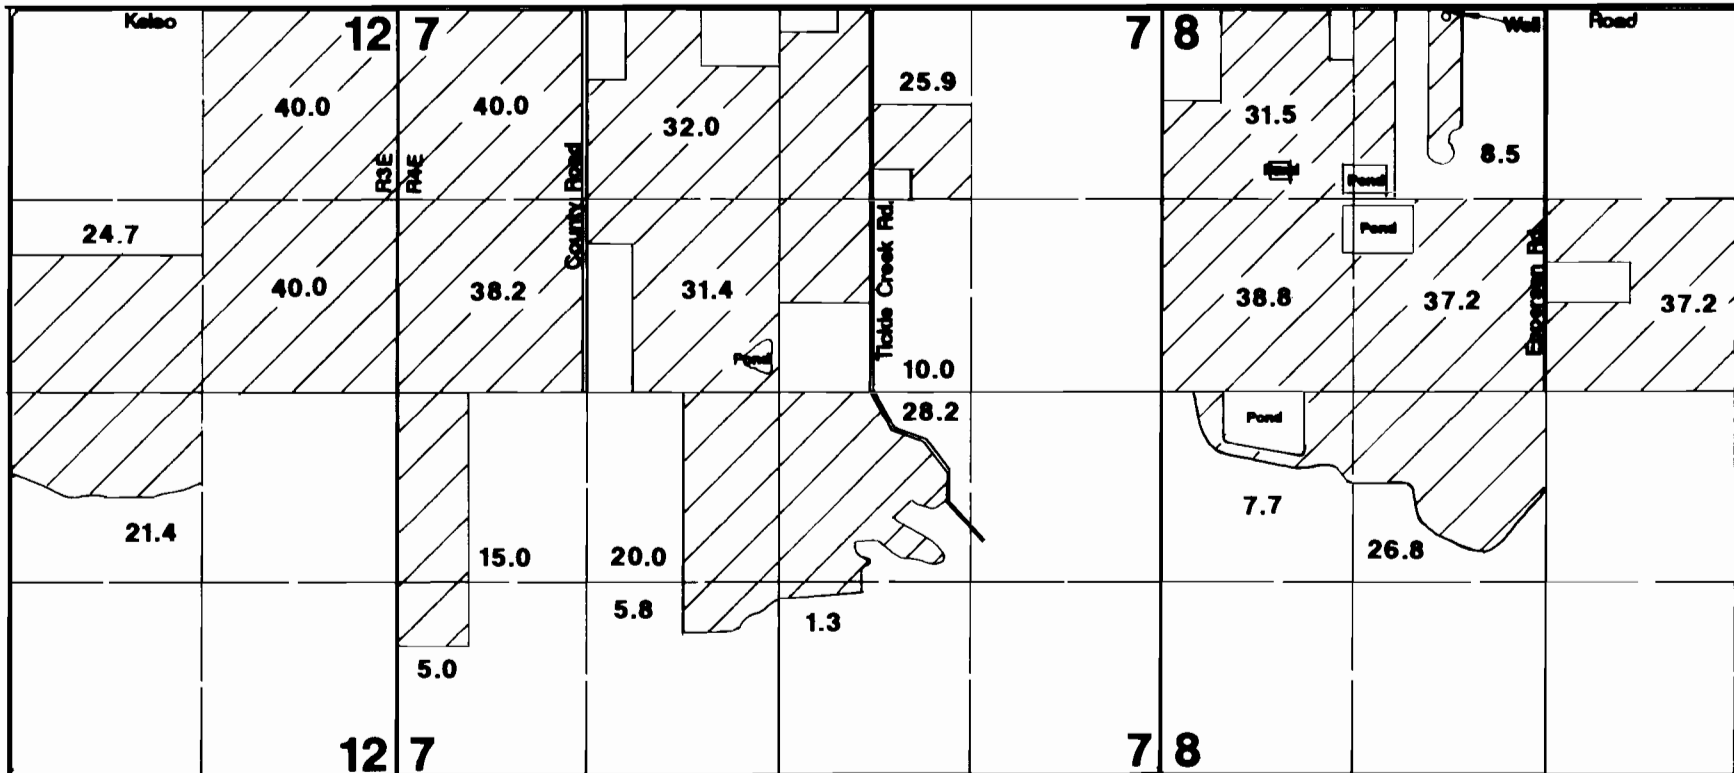


Well located 70'S & 2003'E from NW corner Section 8.

Final Proof Survey

Application #G-11840 Permit #G-11135

In Name Of

Iseli Nursery, Inc.

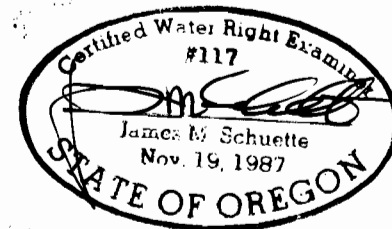

Surveyed on September 21, 1994 by JM Schuette

THIS MAP WAS PREPARED FOR THE PURPOSE OF IDENTIFYING THE LOCATION OF A WATER RIGHT ONLY AND IS NOT INTENDED TO PROVIDE LEGAL DIMENSIONS OR LOCATION OF PROPERTY OWNERSHIP LINES.