

T.1.N.,R3W.,W.M


RECEIVED

SECTION 1 & 2

SEP 19 1994
4470
S.W. 1/4


NE CORNER
T.R. CORNELIUS
D.L.C. 39

CHARLES MCKAY D.L.C. NO. 73

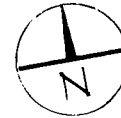

SCALE: 1" = 400'

THE PLACE OF USE LIES
TOTALLY WITHIN THE
CHARLES MCKAY D.L.C. NO. 73

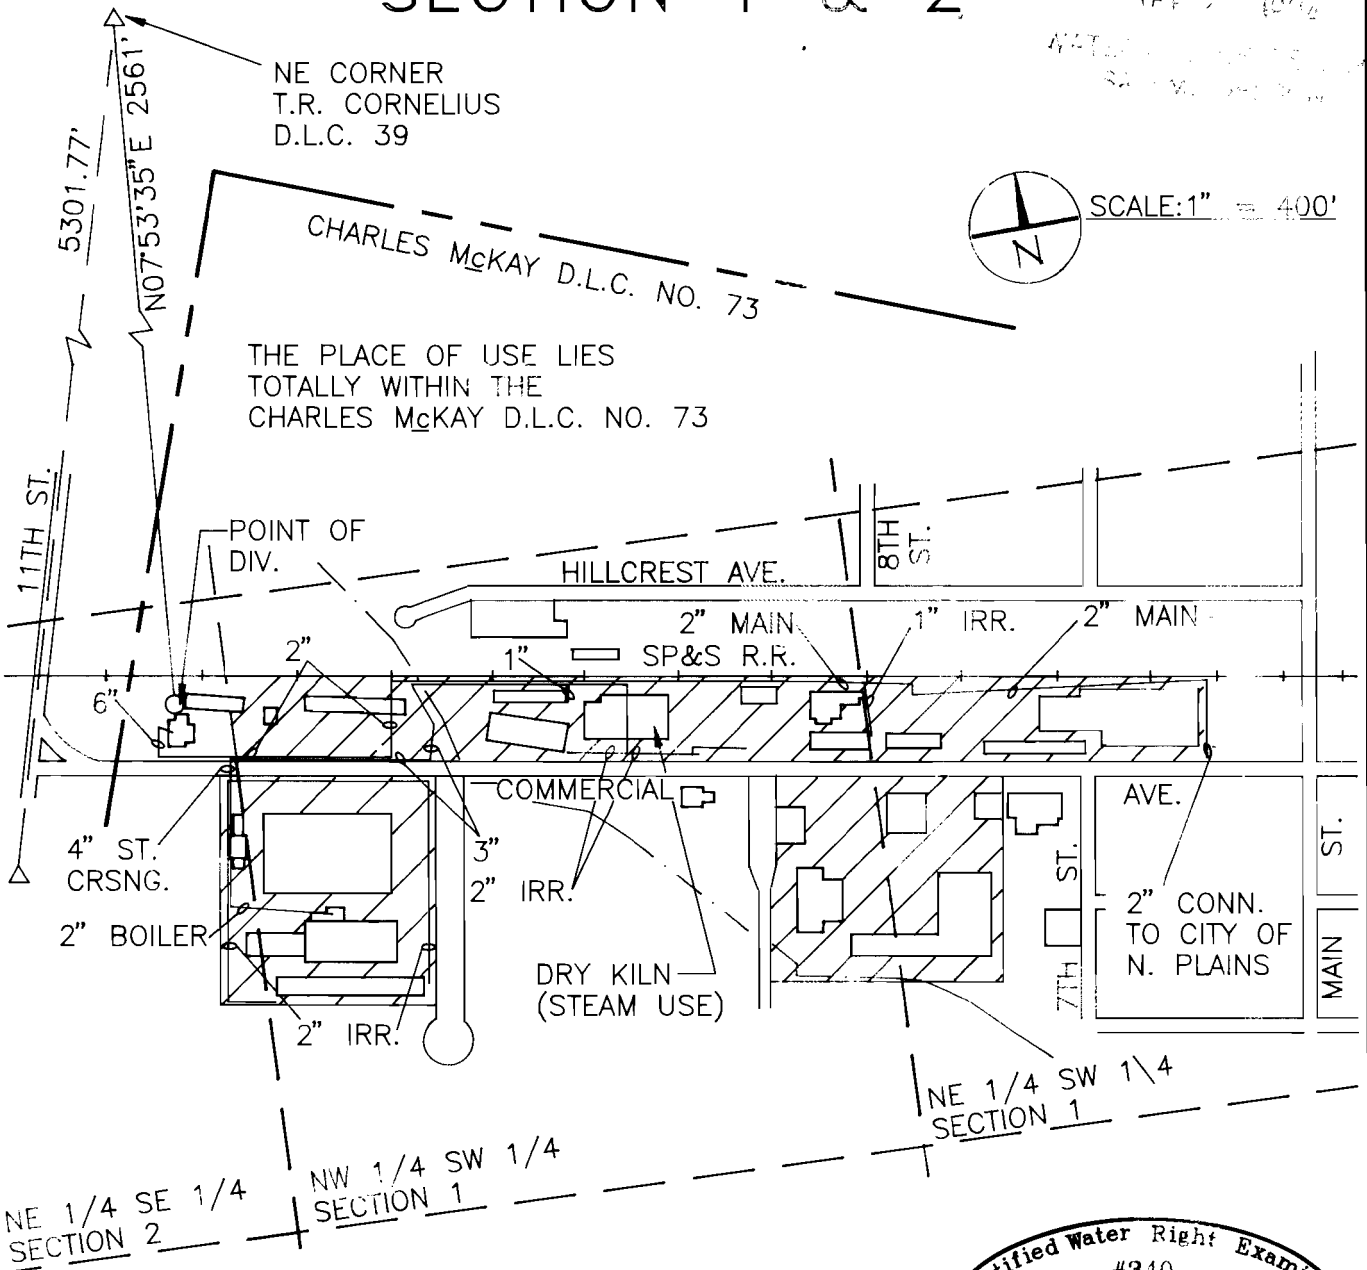

FINAL PROOF SURVEY


UNDER

Application No. G-12086 Permit No. G-11142

IN NAME OF

OREGON CANADIAN FOREST PRODUCTS, INC.
NORTH PLAINS, OREGON

Surveyed APRIL 28, 1993, by DAN KEPPEM

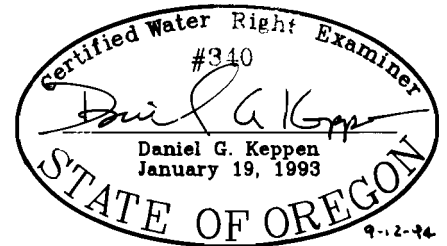

EXPIRES 06/30/95

THIS MAP IS FOR THE PURPOSE
OF IDENTIFYING THE LOCATION OF
THE WATER RIGHT ONLY AND IS
NOT INTENDED TO PROVIDE LEGAL
DIMENSIONS OR THE LOCATION
OF PROPERTY OWNERSHIP LINES.