

RECEIVED

JUL 11 1988

Application No. *G 11831*

Permit No. G11151

TAX LOT No. 18-46C-2100











Sec. 21, Twp. 18 S., R. 46 E., W.M.

RECEIVED
NOV 13 1990
WATER RESOURCES DEPT.
SALEM, OREGON

DISCLAIMER

I, ALBERT GASCHLER, HEREBY CERTIFY: THAT THIS MAP WAS MADE TO BE A PART OF THE APPLICATION FOR A PERMIT TO APPROPRIATE GROUND WATER, SECTIONAL LINES SHOWN ARE APPROXIMATE AND THIS MAP IS NOT INTENDED FOR ANY OTHER USE AND DOES NOT GUARANTEE LAND OWNERSHIP.


LEGEND

- U.S. GOVERNMENT CORNER 
- EXISTING WATER RIGHT 
- SUPPLEMENTAL WATER RIGHT 
- CONCRETE LINED DITCH 
- EARTH DITCH 
- PIPE LINE 
- SPRINKLER LINE 
- PUMP 
- WEIR BOX 
- Primary Right 



SCALE: 1" = 400'

Application No. *G-11831*
Permit No. G11151

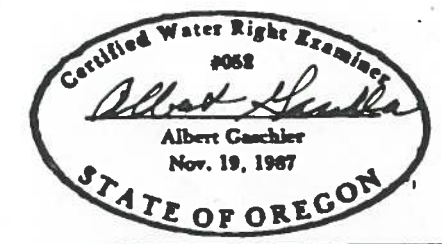


PRIMARY PERMIT No. -4303

WATER RIGHTS EXAMINERS MAP
 FOR: GEORGE KITAMURA

GASCHLER & ASSOCIATES
 ONTARIO, P.O. BOX 412, 889-2101 OREGON

CHECKED BY:	DRAWN BY: <i>A.G.</i>	APPROVED BY:
DATE: 6/22/88	DRAWING NO. A-427	BK 0-1 PG 23
SHEET: 5 OF 5	JOB NO. WRO-2588	REVISED: <i>10/16/90</i>

Albert Gaschler

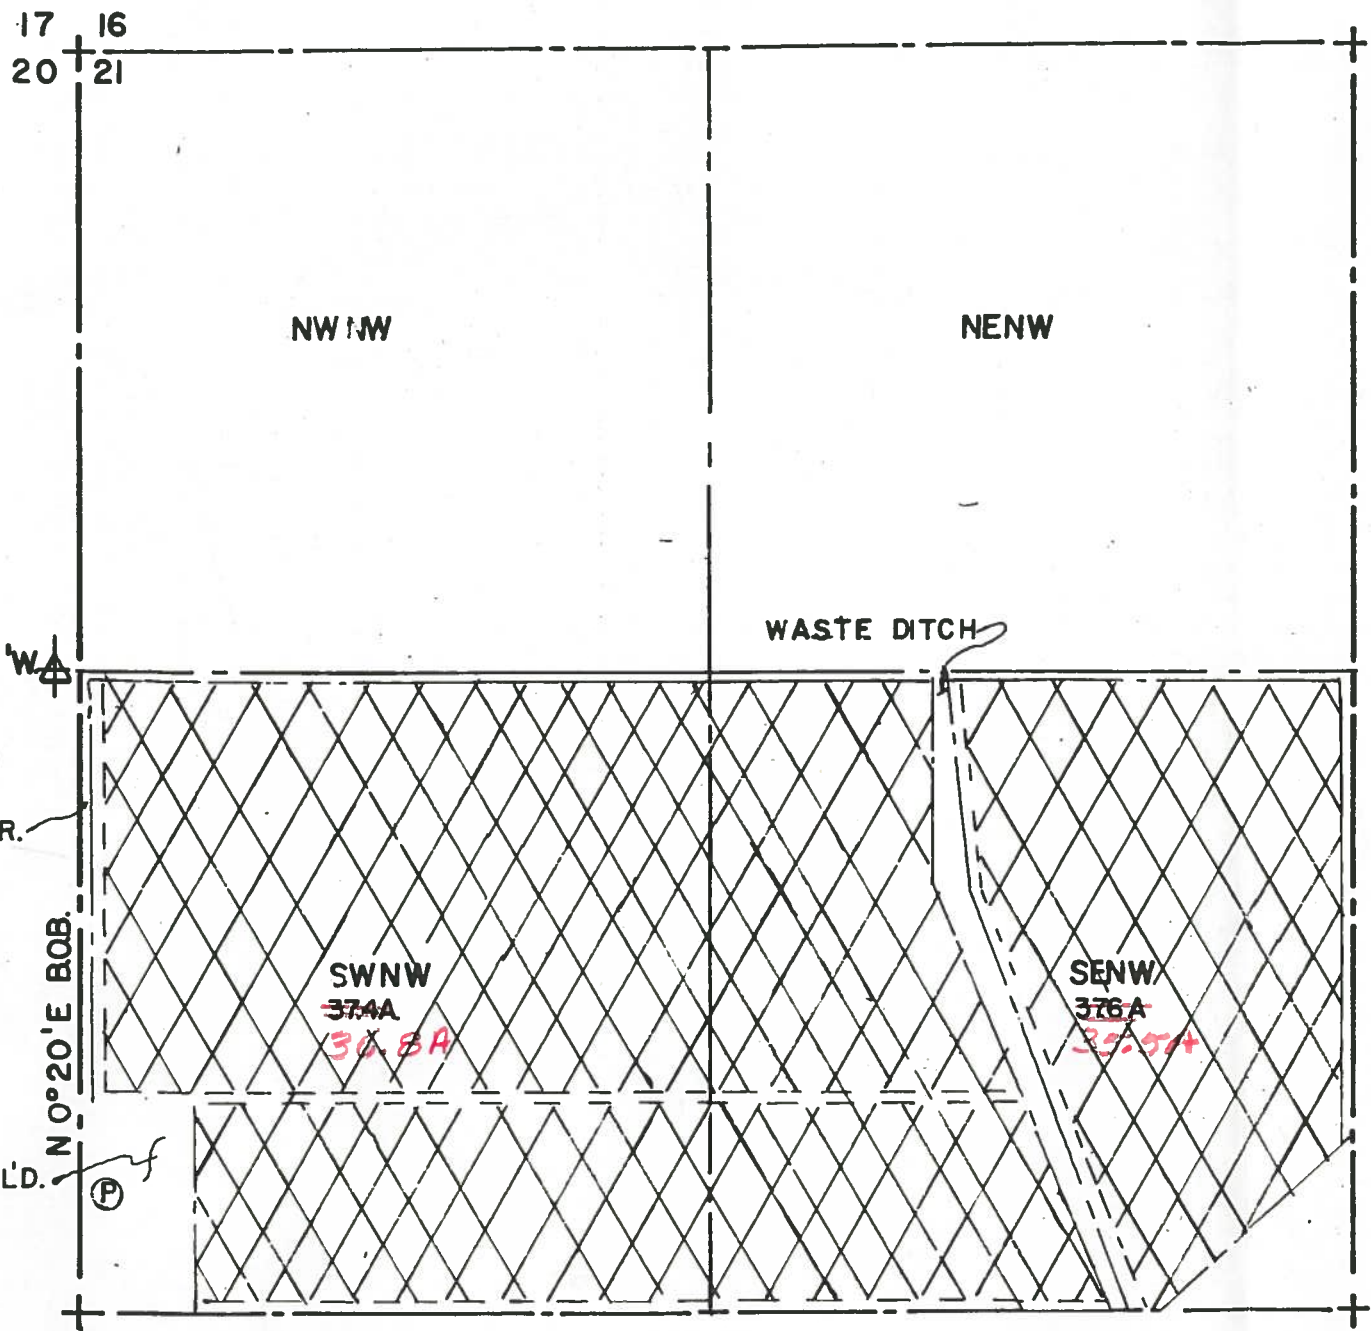

PUMP 1 1559' N. & 45' E. FROM S. 1/16 COR.
" " 2 1559' N. & 54' E. " " " "

S 1/16 20 21