


T.5 S. R. 1 W. W.M.

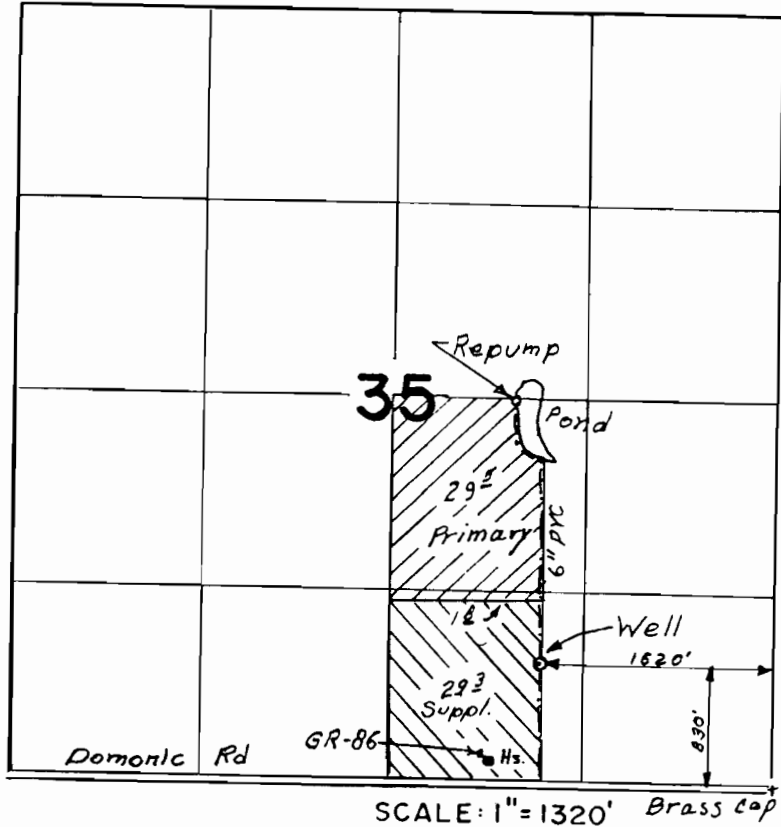

FINAL PROOF SURVEY UNDER

Application No. 612002, Permit No. 611153.....

IN NAME OF

ROBERT FESSLER

THIS MAP WAS PREPARED FOR THE PURPOSE OF IDENTIFYING THE LOCATION OF A WATER RIGHT ONLY AND IS NOT INTENDED TO PROVIDE LEGAL DIMENSIONS OR LOCATION OF PROPERTY OWNERSHIP LINES.

