


T.6S. R.1W. W.M.

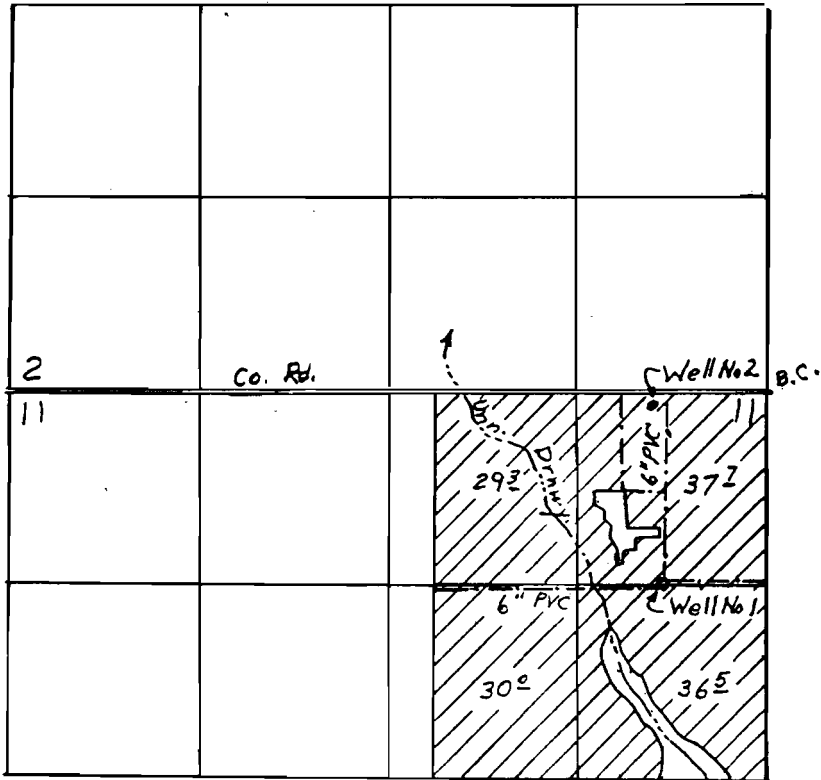

Scale
4" = 1 Mi

Well No 1 is 1304'S & 706' W from NE Cor. Sec 11
 Well No 2 is 80'S & 770' W " " " " "

FINAL PROOF SURVEY UNDER

Application No. 612003. Permit No. 611154.....
 IN NAME OF

ROBERT FESSLER

THIS MAP WAS PREPARED FOR THE
 PURPOSE OF IDENTIFYING THE LOCA-
 TION OF A WATER RIGHT ONLY AND IS
 NOT INTENDED TO PROVIDE LEGAL
 DIMENSIONS OR LOCATION OF PROPER-
 TY OWNERSHIP LINES.

